


# T.37 S., R.7 W., W.M.

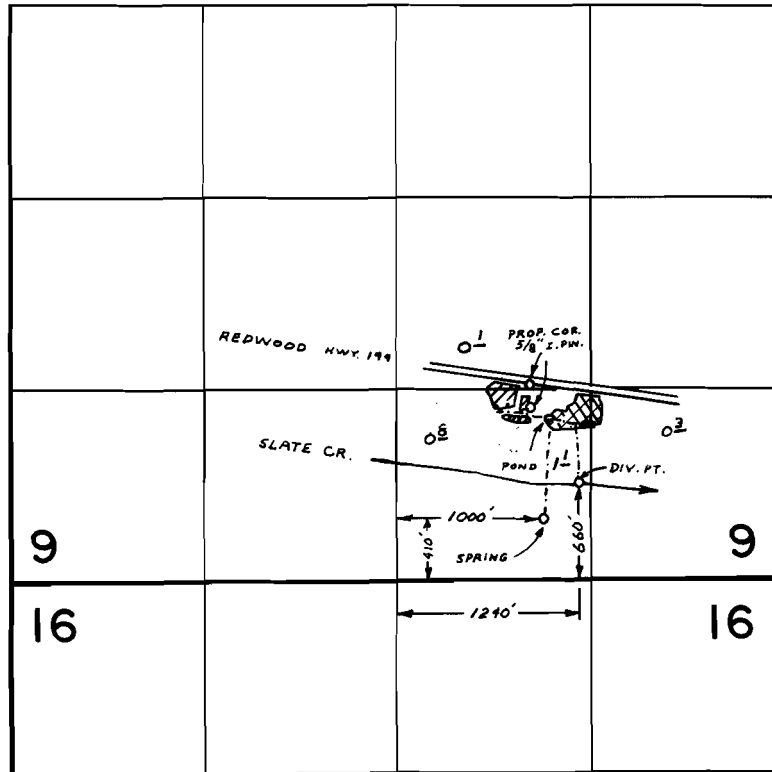

SLATE CREEK



SPRING

## FINAL PROOF SURVEY UNDER

Application No. 50057 Permit No. 37624  
IN NAME OF

RUSSEL J. HUDSON

Surveyed JUL. 27 1978, by B. SUND