


T. 29 S., R. 4 W., W.M.

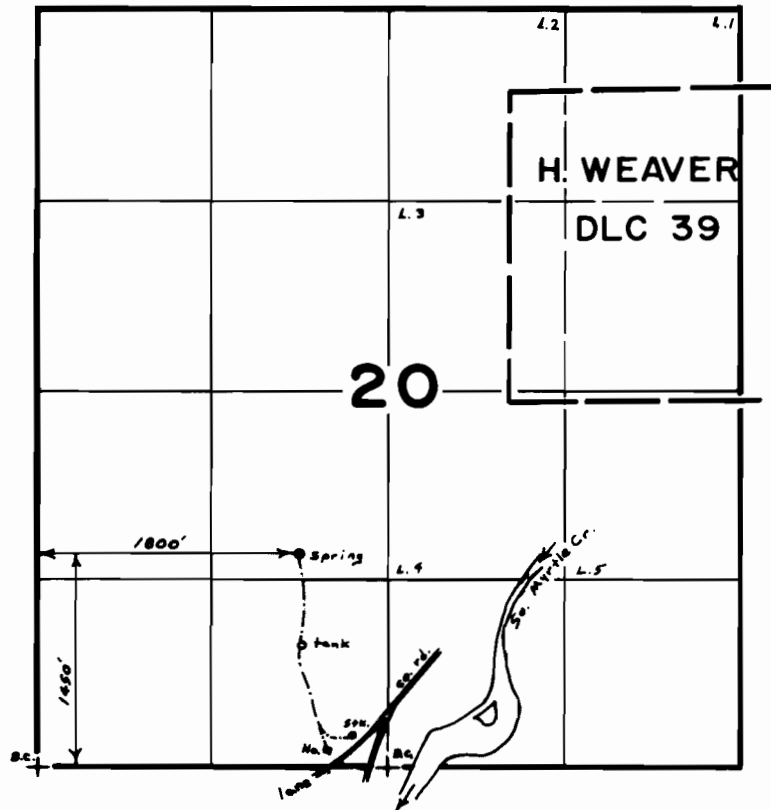

SCALE 4"=1 mile

FINAL PROOF SURVEY
UNDER

Application No. **511.7.9**... Permit No. **386.7.7**....
IN NAME OF

.....**WILLIE R. McCARLEY**.....

Surveyed **Sept. 7, 1979**, by **S. Donaldson**....