


T.19S.R.44E.W.M.

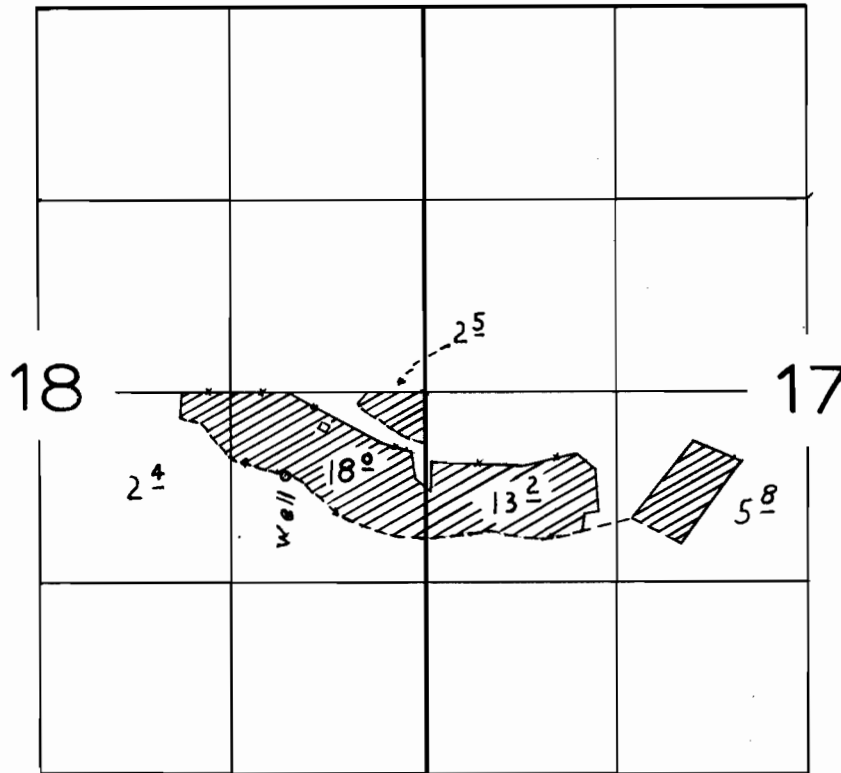

FINAL PROOF SURVEY
UNDER

Application No. *G-1340* Permit No. *G-1226*
IN NAME OF

WARREN B. SCHLUPE

Surveyed *November 12 1963*, by *F.W. Elfering*