



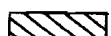

G-6771  
67946

# T. 41S., R. 10E., W.M.

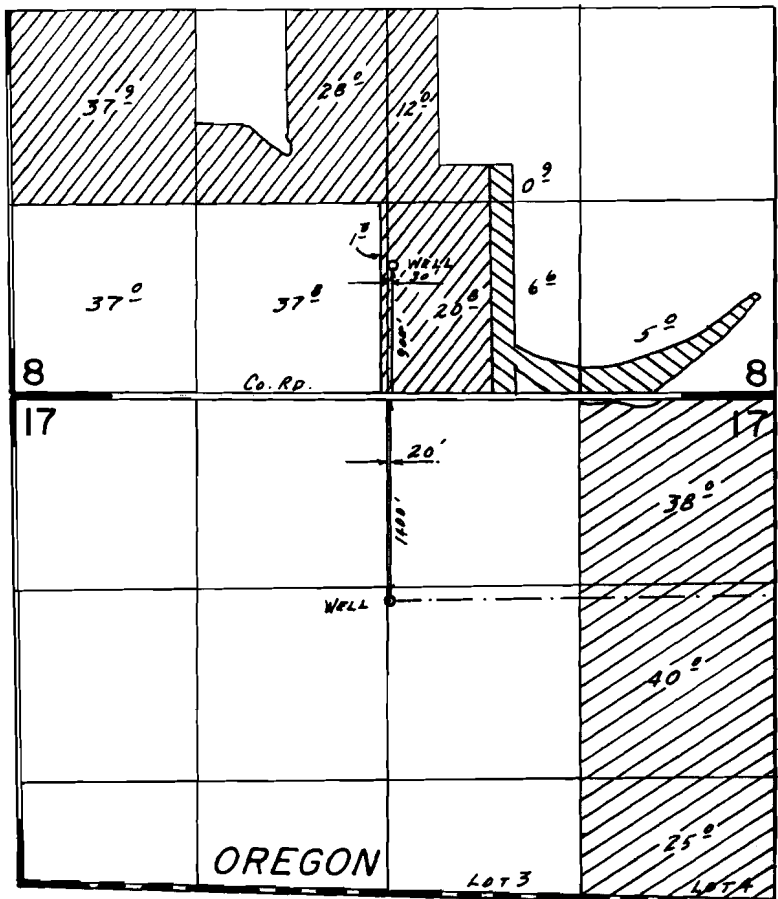

OREGON CALIFORNIA

SCALE: 1"=1320'

-  Permit G-6771
-  Permit G-9623
-  Permit G-10422

## FINAL PROOF SURVEY UNDER

G-7333                      G-6771  
G-9646                      G-9623

Application No. G-11228 Permit No. G-10422..  
IN NAME OF

...CHARLES G. & SUSAN KERR...

Surveyed Oct...4..... 19.88, by B.W.BISHOP.....

2/2/89  
BWB

CNO-5JJ-2408241

Lot 3