


G-9623
07947




T. 41 S., R. 10 E., W. M.

Lost Rev. Wells

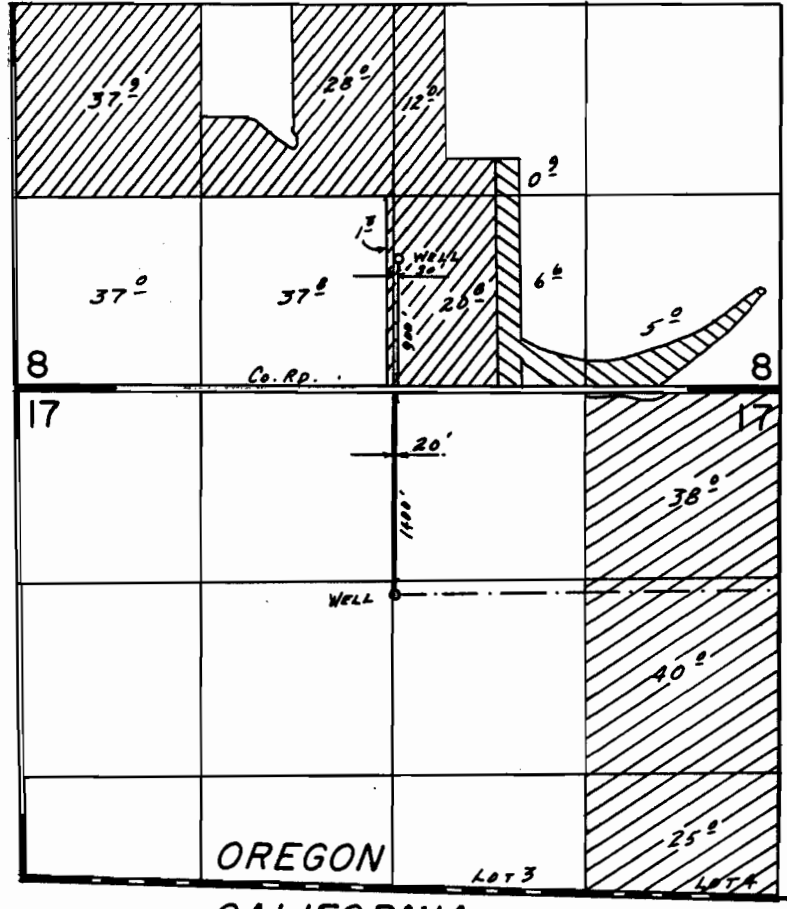

OREGON
CALIFORNIA

SCALE: 1" = 1320'

-  Permit G-6771
-  Permit G-9623
-  Permit G-10422

FINAL PROOF SURVEY UNDER

G-7333 G-6771
 G-9646 G-9623
 Application No. G-11228 Permit No. G-10422..
 IN NAME OF

CHARLES G. & SUSAN KERR

Surveyed Oct. 4, 1988, by R.W. BISHOP.....

2/2/89
RWB
CNO-5JJ-2408241