


T. 35 S., R. 2 W., W.M.

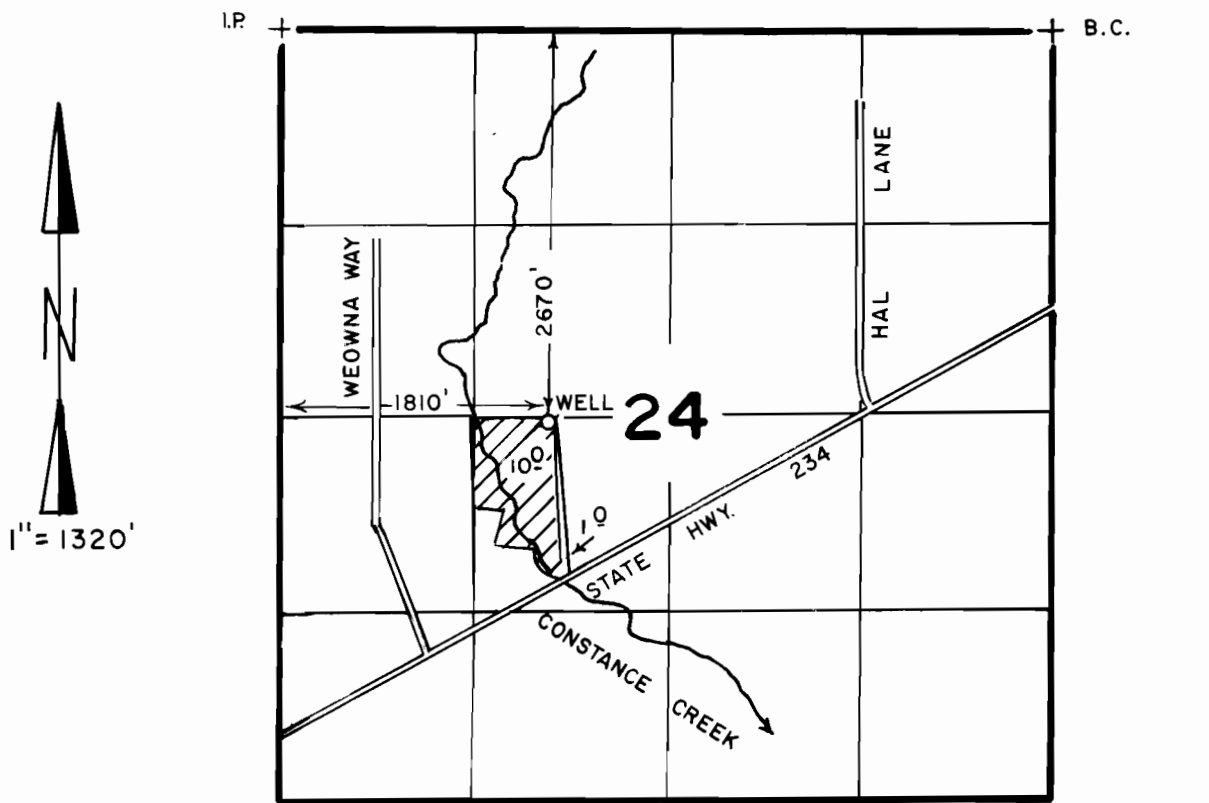

IRRIGATION



OVER ACREAGE

FINAL PROOF SURVEY UNDER

Application No. G-10710 Permit No. G-9836
IN NAME OF

MICHAEL L. & BOBBIE J. RAINEY

Surveyed FEB. 27. 1990, by B. S. JAMES

5-7-90 DSM

4-1029-279-248L