


T. 41 S. R. 13 W. W.M.

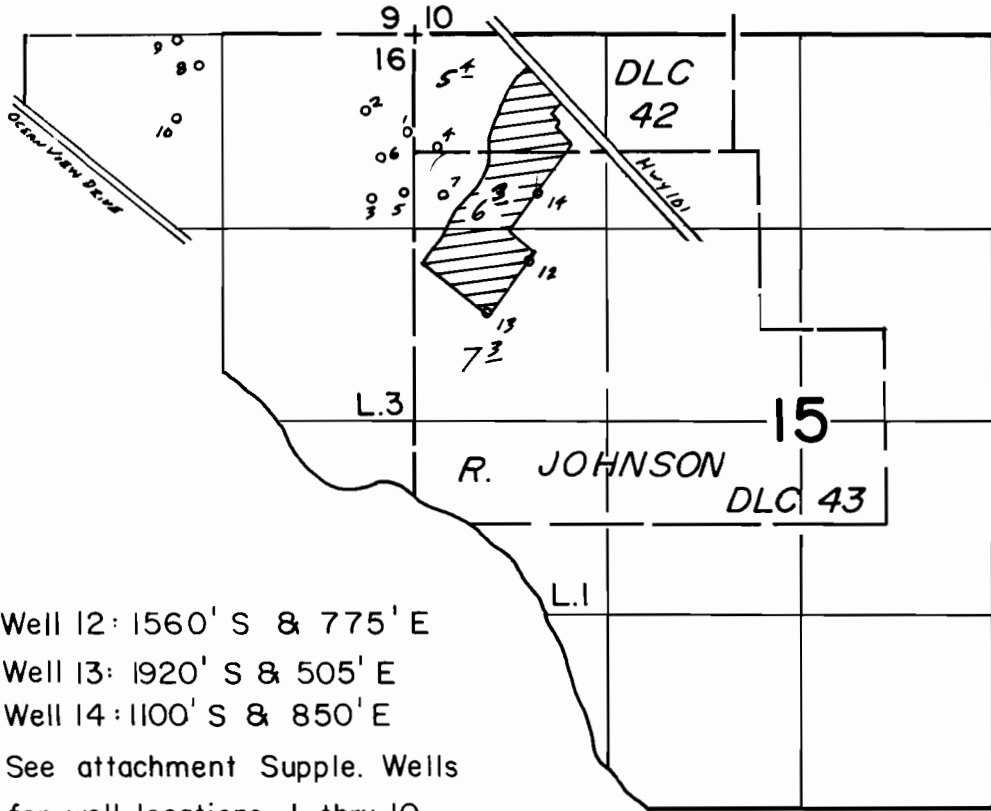

Well 12: 1560' S & 775' E  
Well 13: 1920' S & 505' E  
Well 14: 1100' S & 850' E  
See attachment Supple. Wells  
for well locations 1 thru 10.

Scale 1" = 1320'

**FINAL PROOF SURVEY**  
UNDER

Application No. G-11017 Permit No. G-10121  
IN NAME OF

...OREGON...HYDRANGEA...CO.....

Surveyed Sept. 23, 1991., by B.S. JAMES...

41015-1343-1522  
4101-180-1430