


T.21S., R.4W., W.M.

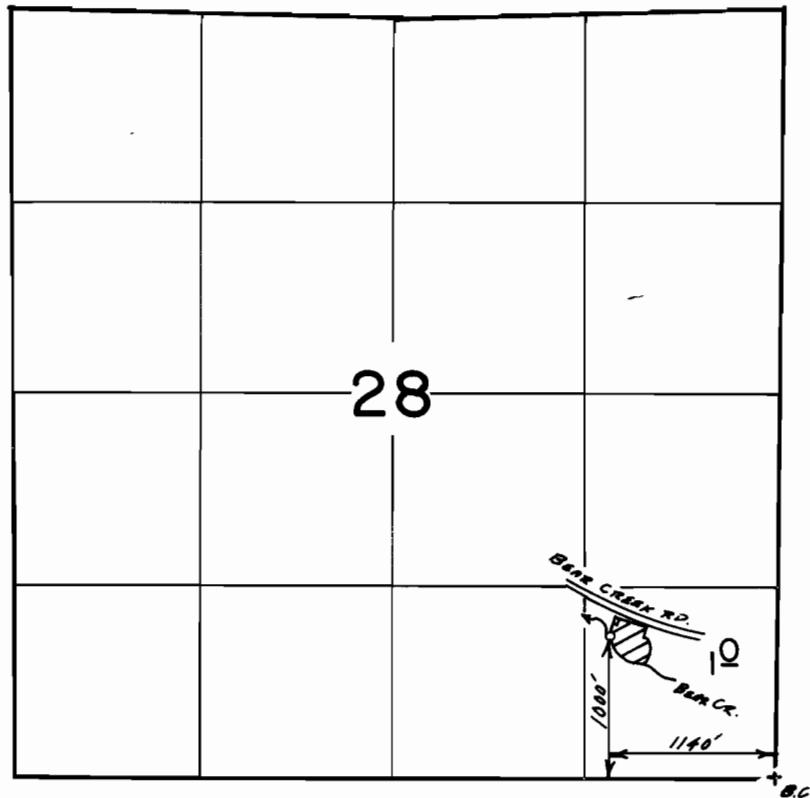

Scale: 1320'



FINAL PROOF SURVEY
UNDER

Application No. 51093 Permit No. 38550...
IN NAME OF

.....SIGMUND.....MACHLANSKI.....

Surveyed Aug. 21 1991, by B.S.JAMES.....

41019-378-2708

3/02