


T. 34 S., R. 4 W., W. M.

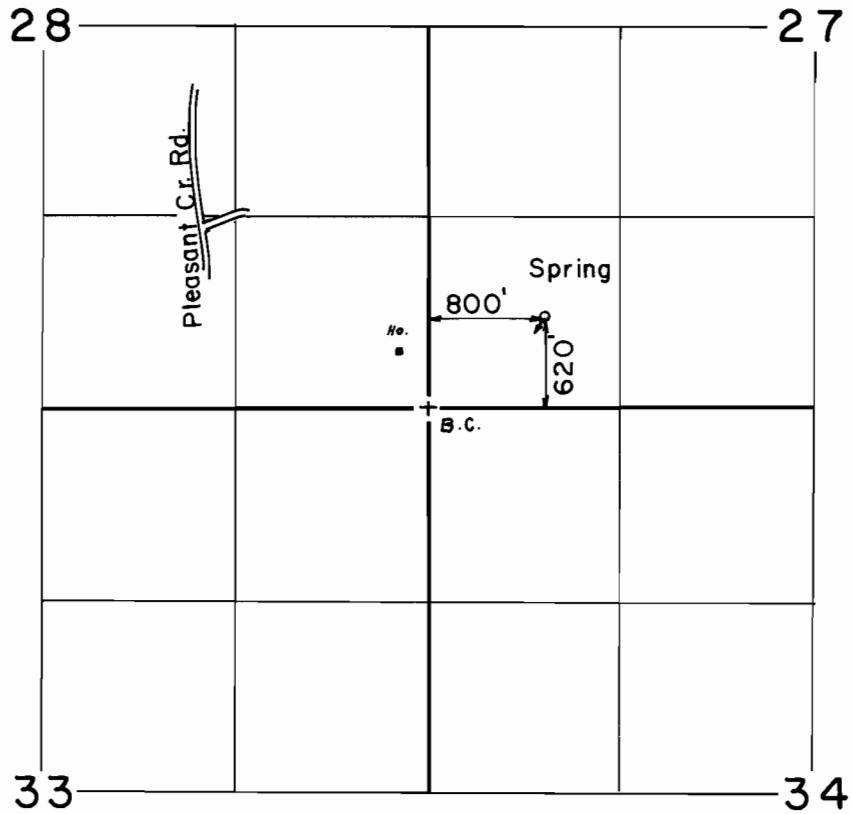

Scale: 1" = 1320'

FINAL PROOF SURVEY
UNDER

Application No. 51316. Permit No. 38746..
IN NAME OF

.....MANUEL.....CARVALHO.....

Surveyed JAN...7... 1992, by B..S...JAMES....