


T. 22 S., R. 7 & 8 W., W.M.

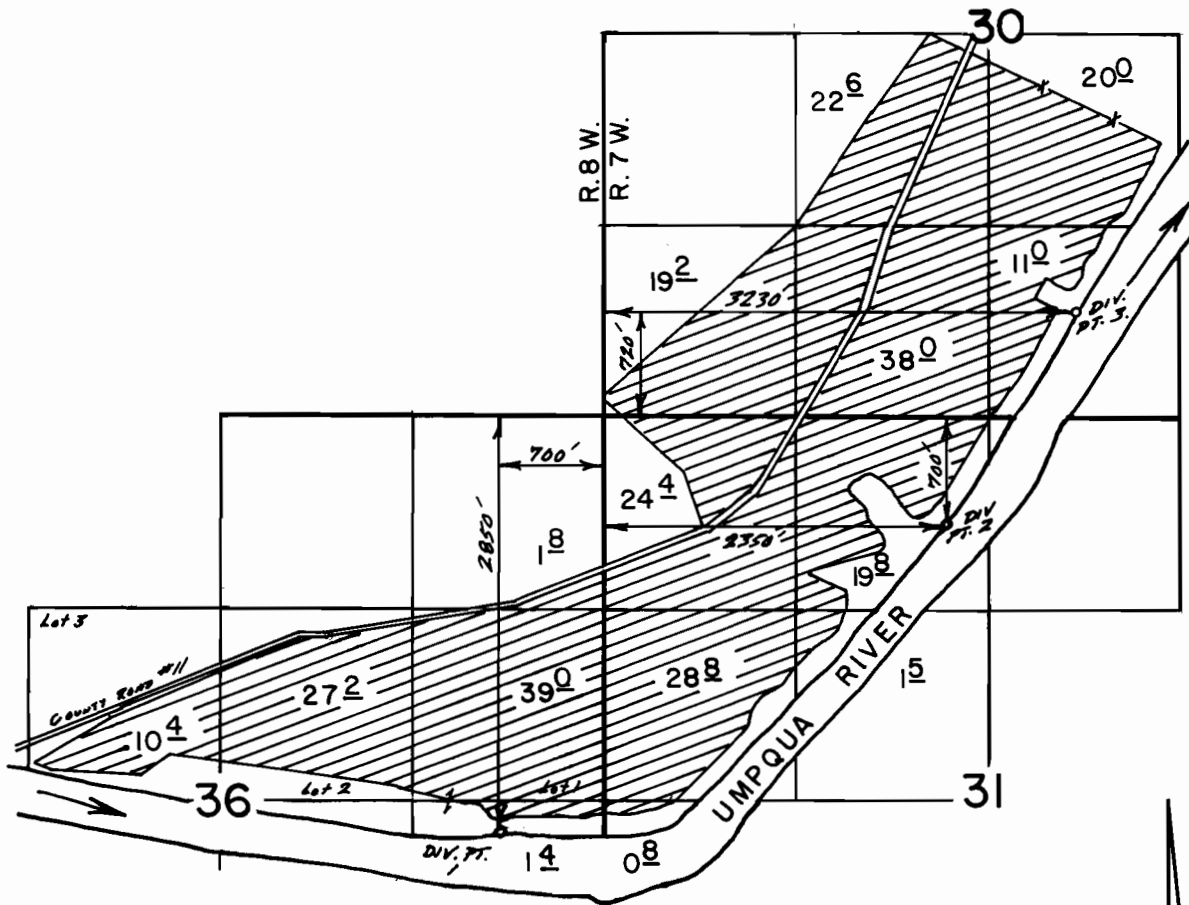

Scale 1" = 1320'

FINAL PROOF SURVEY
UNDER

Application No. 52632 Permit No. 39672
IN NAME OF

.....HENRY.....BECKLEY.....

Surveyed Sept..... 1990, by J.M. Schmorde
Aug. 15, 1991, by B.S. James