


T. 27S., R. 2W., W.M.

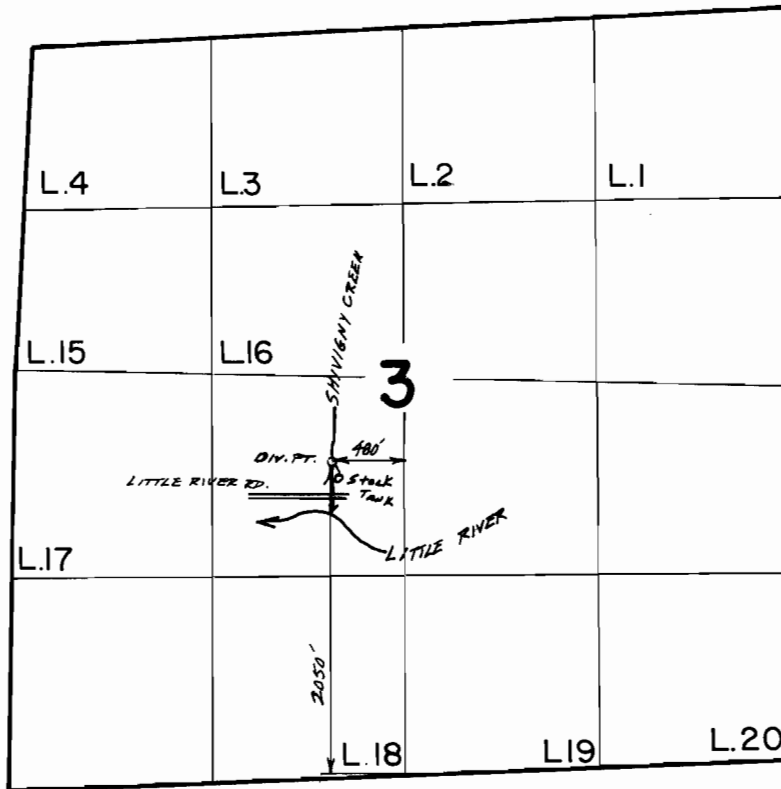

Scale 1"=1320'

**FINAL PROOF SURVEY  
UNDER**

Application No. 54127. Permit No. 40519.....  
IN NAME OF

.....JACK...A...MORNARICH.....

Surveyed Aug.27, 1991., by B.S. James.....