


90884

# T.29S., R.14W., W.M.

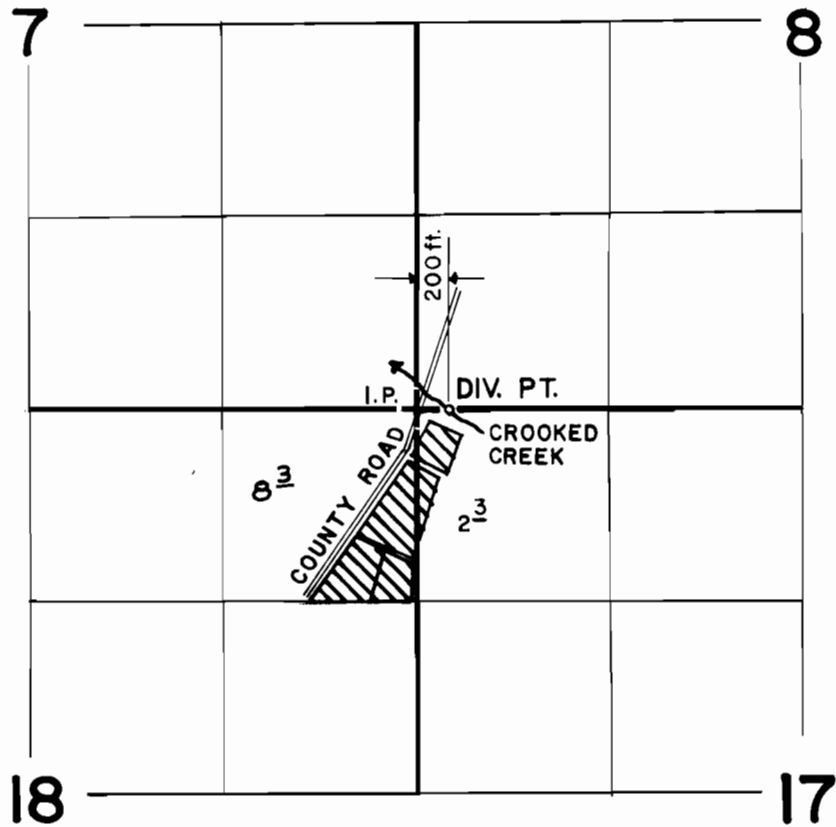

SCALE: 4" = 1 MILE

## FINAL PROOF SURVEY UNDER

Application No. 54583 Permit No. 40958  
IN NAME OF

HARDY CHRISTENSEN

Surveyed NOV. 20, 1985, by J. M. SCHMORDE