

T.6N., R.35E., W.M.

FINAL PROOF SURVEY UNDER

APPL. 55612 PER. 43095


IN NAME OF

EAST MUD CREEK WATER USERS DIST.


SURVEYED 6-22-83
3-25-87

by V. L. Church

Div. Pt. 5 Loc: 370'N. & 340'W. } FROM S 1/4 COR. SEC. 22
 Div. Pt. 6 Loc: 920'N & 1300'W. }
 Div. Pt. 7 Loc: 3100'S. & 1140'E. } FROM NW COR. SEC. 22
 Div. Pt. 8 Loc: 2330'S. & 540'E. }
 Div. Pt. 9 Loc: 1300'S. & 10'E. }
 Div. Pt. 10 Loc: 1300'S. & 400'W. }
 Div. Pt. 11 Loc: 570'N. & 2120'W. }

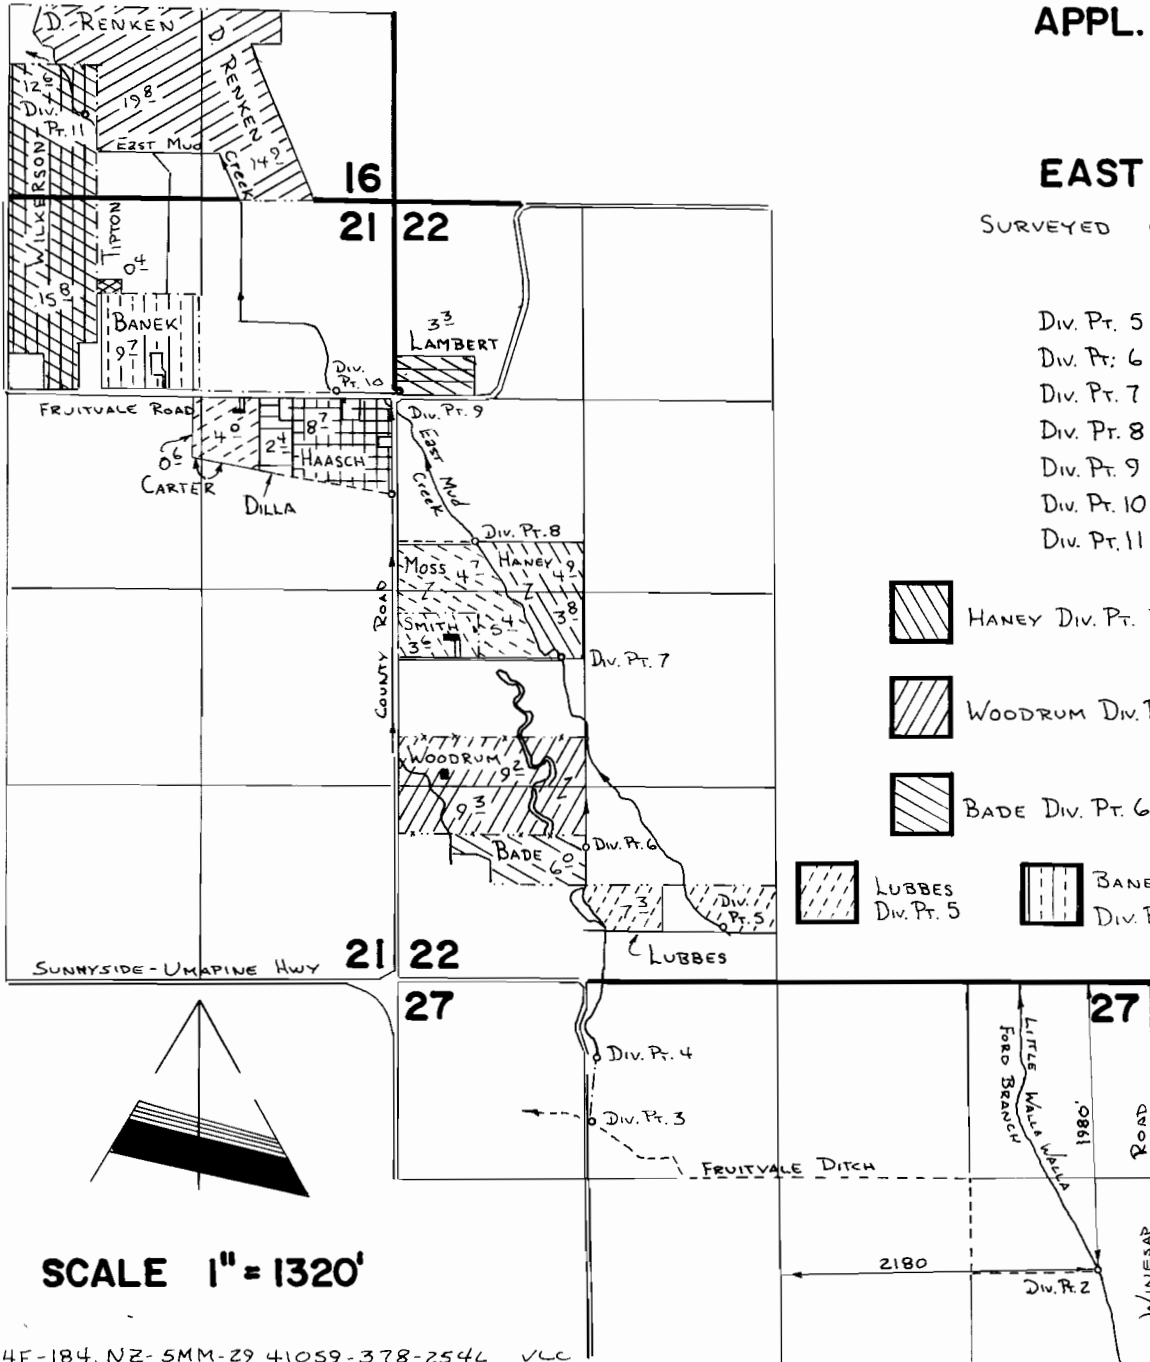

- | | | | | | |
|--|--------------------|--|-----------------------|--|----------------------------|
| | HANEY Div. Pt. 7 | | MOSS Div. Pt. 7 | | WILKERSON Div. Pt. 11 & 10 |
| | WOODRUM Div. Pt. 6 | | D. RENKEN Div. Pt. 10 | | DILLA Div. Pt. 8 |
| | BADE Div. Pt. 6 | | TIPTON Div. Pt. 10 | | SMITH Div. Pt. 7 |
| | LUBBES Div. Pt. 5 | | BANEK Div. Pt. 10 | | HAASCH Div. Pt. 8 |
| | | | CARTER Div. Pt. 8 | | LAMBERT Div. Pt. 9 |

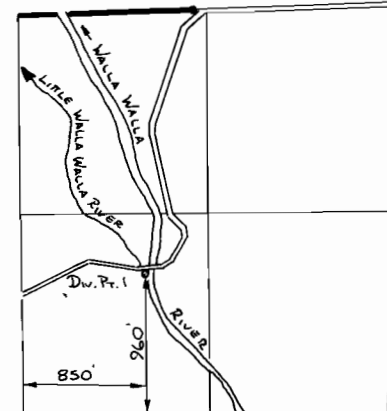

NE 1/4
SEC. 12
T. 5N.,
R. 35E.,
W.M.

SCALE 1" = 1320'