


T. 25 S., R. 6 W., W. M.

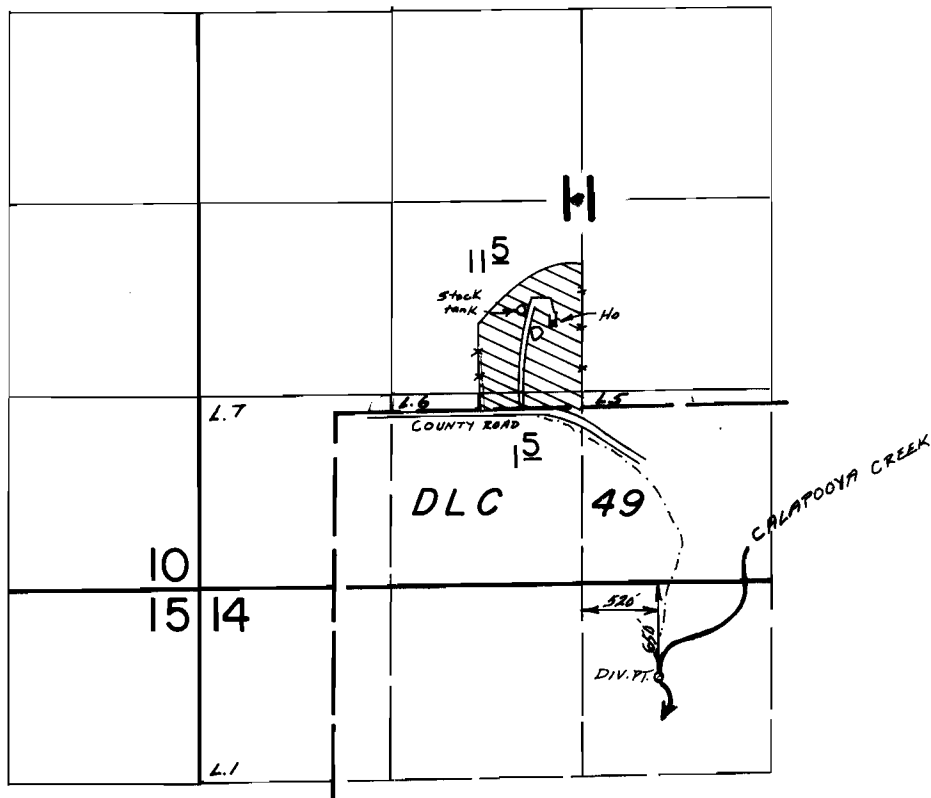

Scale 1" = 1320'

**FINAL PROOF SURVEY**  
UNDER

Application No. 55.725 Permit No. 42.064...  
IN NAME OF

.....PHILLIP R. TURNBULL.....

Surveyed July 17, 1986, by M. Schmorde.