

17

16

15

14

13

37 S R 20 E W 1/2

20

21

22

23

24

STATE ENGINEER
RECEIVED

NOV 4 1922

29

28


27

26

25

SALEM, OREGON

App. 8410, 8411
Per. # 5685, R 536

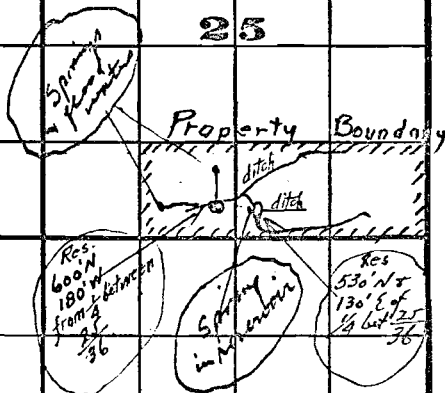

32

33

34

35

36

5685
6796