


T. 22S., R. 7 W., W.M.

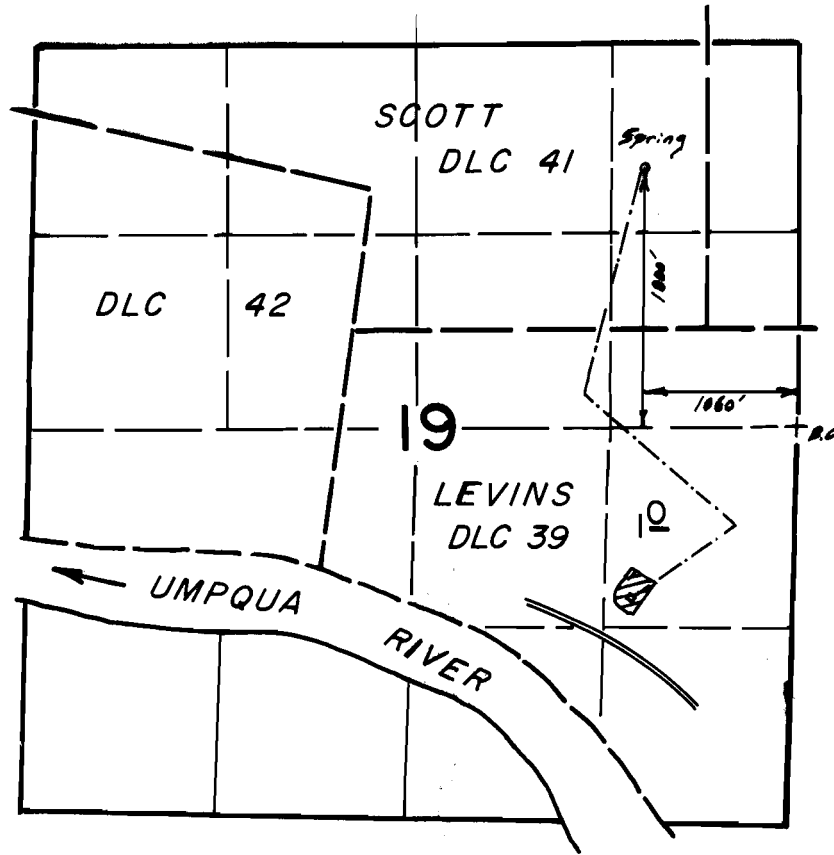

Scale 1" = 1320'

FINAL PROOF SURVEY
UNDER

Application No. 56258 Permit No. 42291....
IN NAME OF

..... HENRY BECKLEY

Surveyed Aug. 8, 1991, by B.S. JAMES.....