


T. 38 S., R. 2 W., W. M.

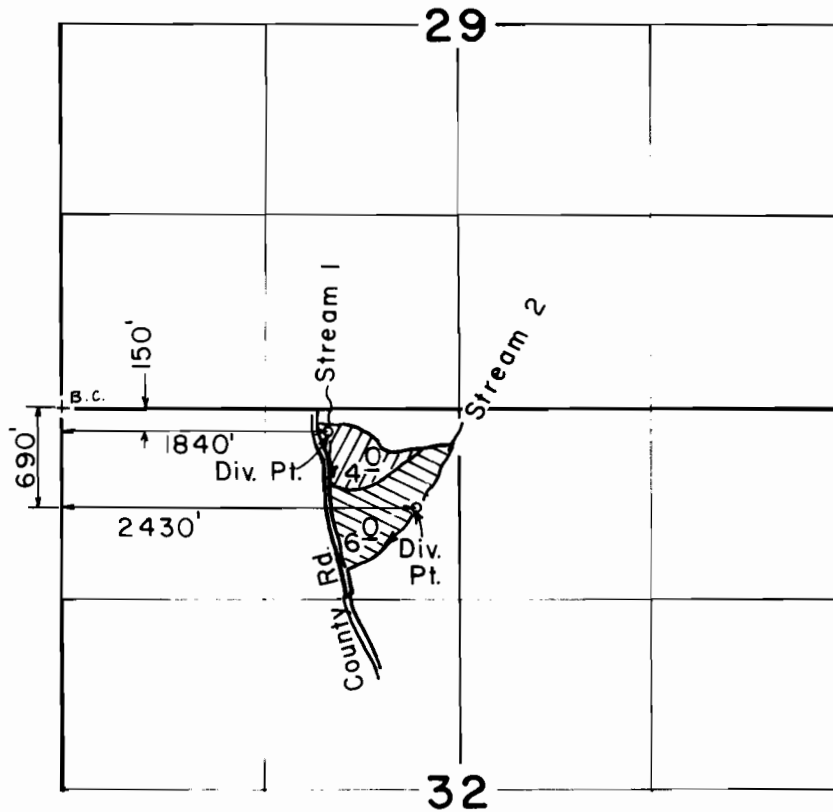

Scale: 1" = 1320'

**FINAL PROOF SURVEY
UNDER**

Application No. 57237. Permit No. 43054...
IN NAME OF

..... LEON O. DE BERRY

Surveyed SEP. 14. 1991., by B. S. JAMES....