


T. 40 S., R. 2 W., W. M.

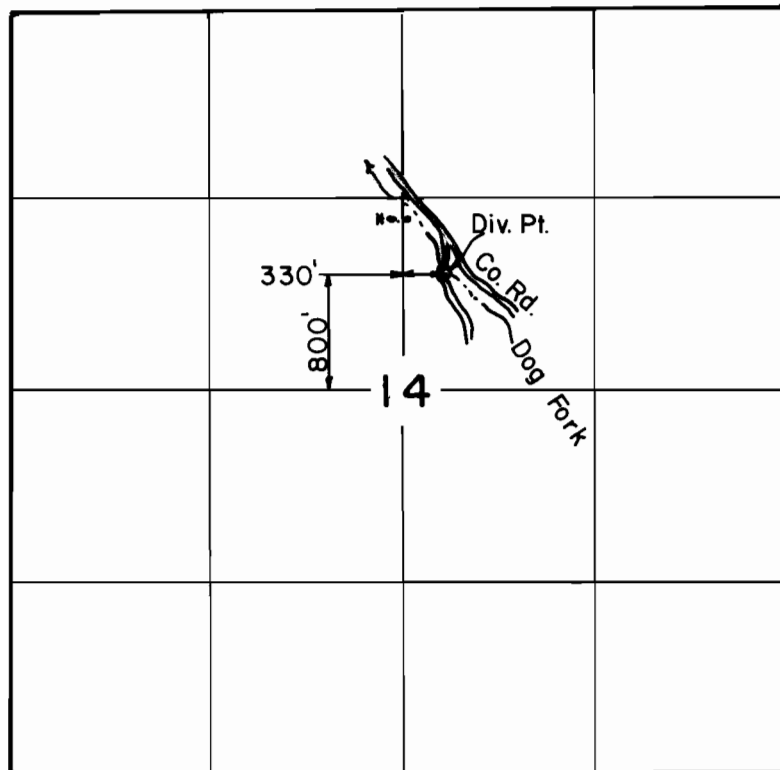

Scale: 1" = 1320'

**FINAL PROOF SURVEY
UNDER**

Application No. 57942 Permit No. 43675...
IN NAME OF

.....JACQUELINE DEVINETTE.....

Surveyed AUG..5.. 1991., by R..S..JAMES....