T. 25 & 26 S., R. 6 W., W.M.

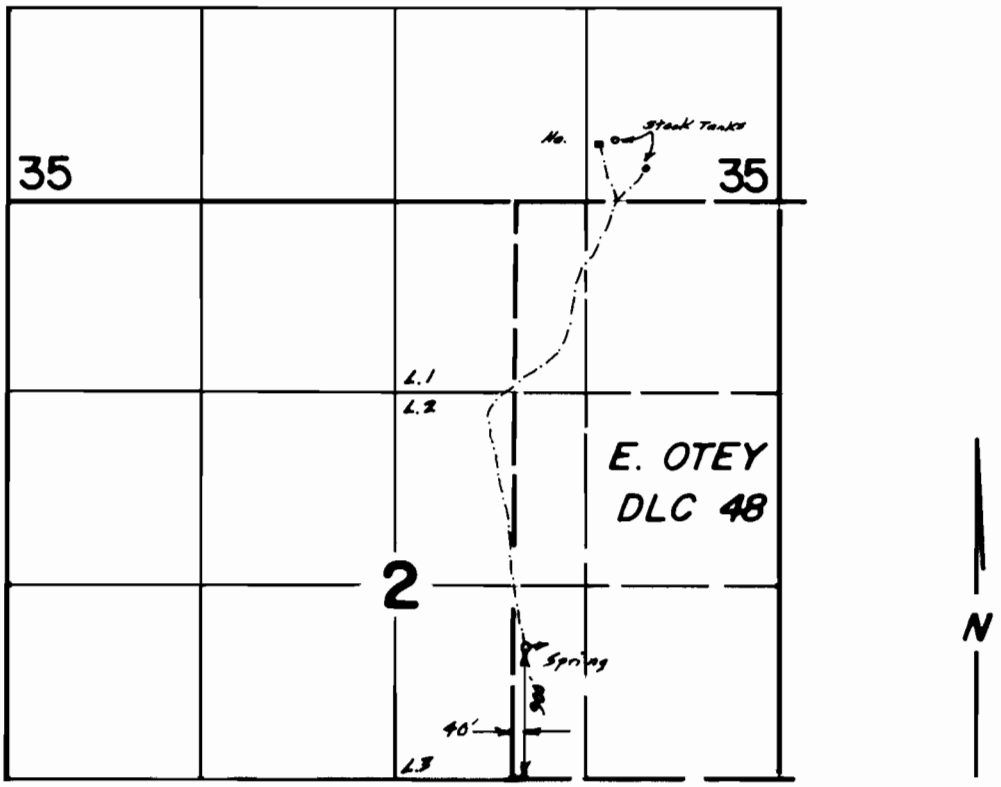

Scale 1" = 1320'

FINAL PROOF SURVEY
UNDER

Application No. 58209 **Permit No.** 43896
IN NAME OF

A. H. NYLEN

Surveyed July 24, 1986, **by** M. Schmorde
Oct. 16, 1991 by B.S. James

25S-6W-SE ¼ QUAD MAP