



T. 17 S., R. 9 W., W.M.

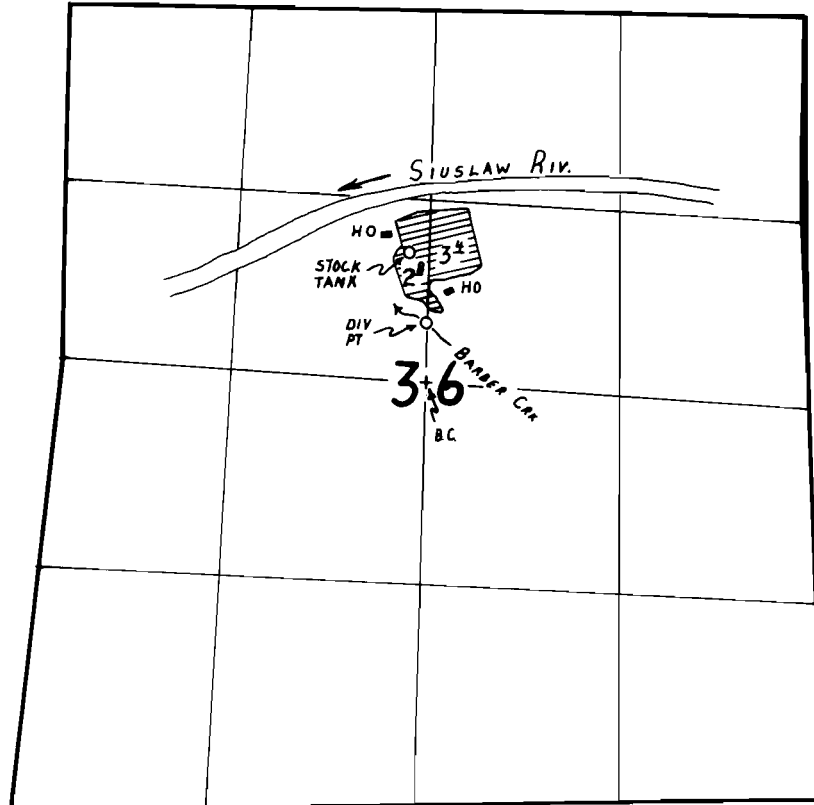

DIV PT LOCATION: 400 FT NORTH FROM THE CENTER 1/4 CORNER OF SECTION 36

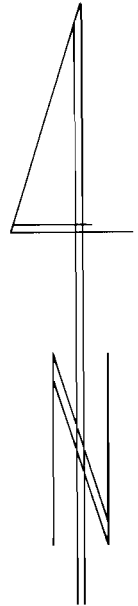

1" = 1320'

FINAL PROOF SURVEY

UNDER

Application No. 58314 Permit No. 44027
IN NAME OF

J. PETER RIAL

Surveyed SEPTEMBER 16, 1990, by B.W. BISHOP