


T. 22 S., R. 4 W., W.M.

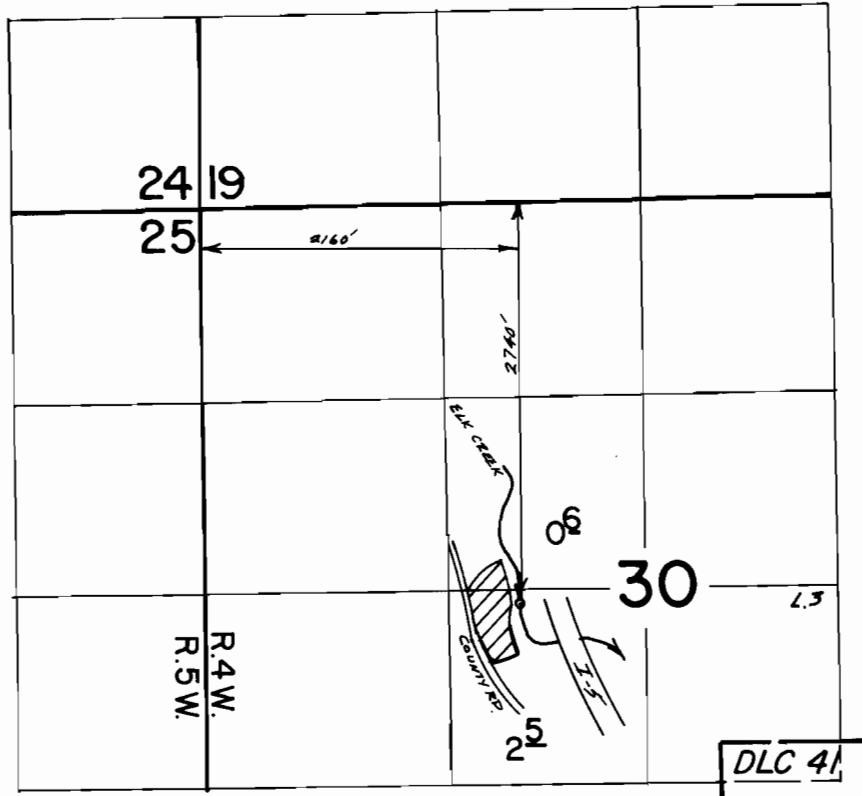

Scale 1"=1320'

**FINAL PROOF SURVEY
UNDER**

Application No. 58863 Permit No. 44436
IN NAME OF

CHARLES L. BOAN

Surveyed Aug. 22., 1991., by S. James