




T. 34 S., R. 5 & 6 W., W.M.

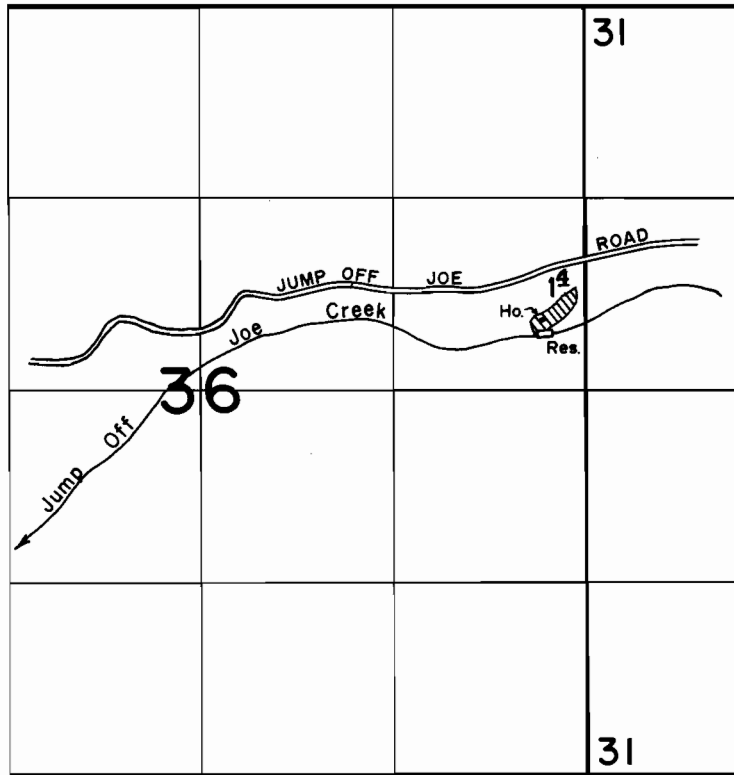

DAM LOC.: 370' N & 330' W. FROM E. 1/4 CORNER SECTION 36

SCALE: 1" = 1320'

FINAL PROOF SURVEY UNDER

R-58938 R-8143

Application No. 58939. Permit No. 44915.....

IN NAME OF

GRANT R. JONES.....

Surveyed MAY 15..... 1989, by B.S. JAMES.....