



T. 21 S., R. 4 W., W. M.

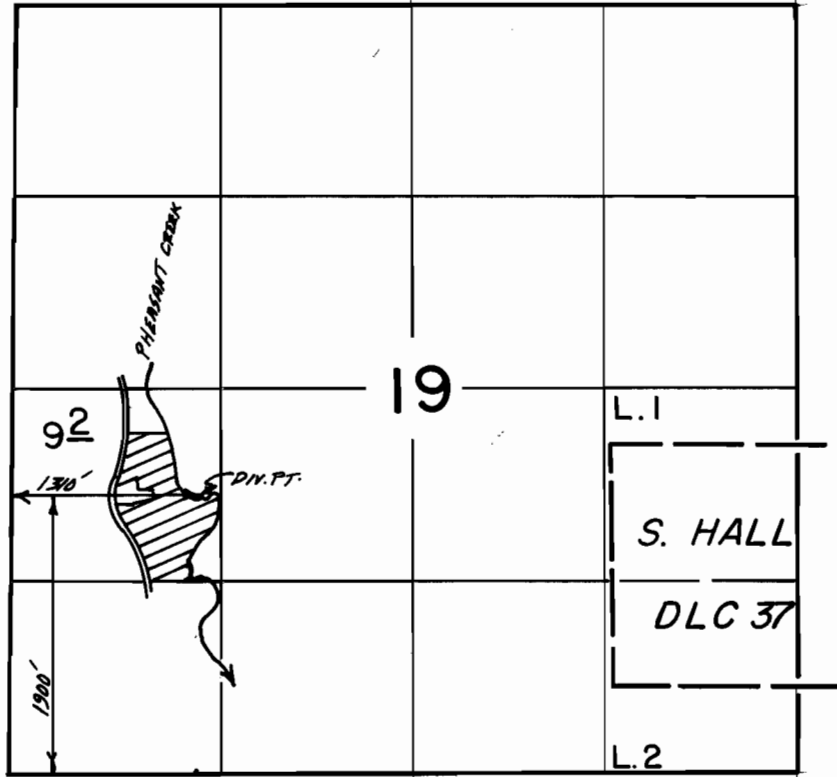

Scale 1"=1320'

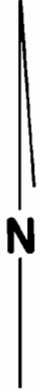

FINAL PROOF SURVEY
UNDER

Application No. 59873 Permit No. 44994
IN NAME OF

THOMAS S. DUNCAN

Surveyed Aug. 21, 1991, by B.S. JAMES