


T. 33 S., R. 7 W., W.M.

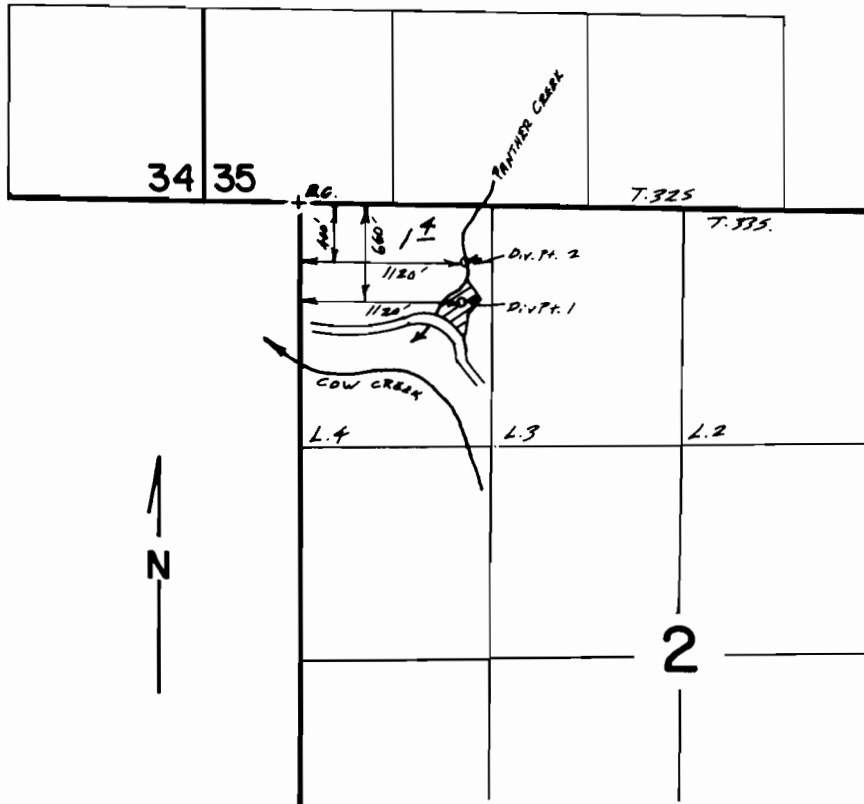

Scale 1" = 1320'

**FINAL PROOF SURVEY
UNDER**

Application No. 60147. Permit No. 45141.....
IN NAME OF

.....ALBERT O. LAMPERT.....

Surveyed July 24, 1990, by L.M. JOACHIMS