


T.20S., R. 25E., W.M.

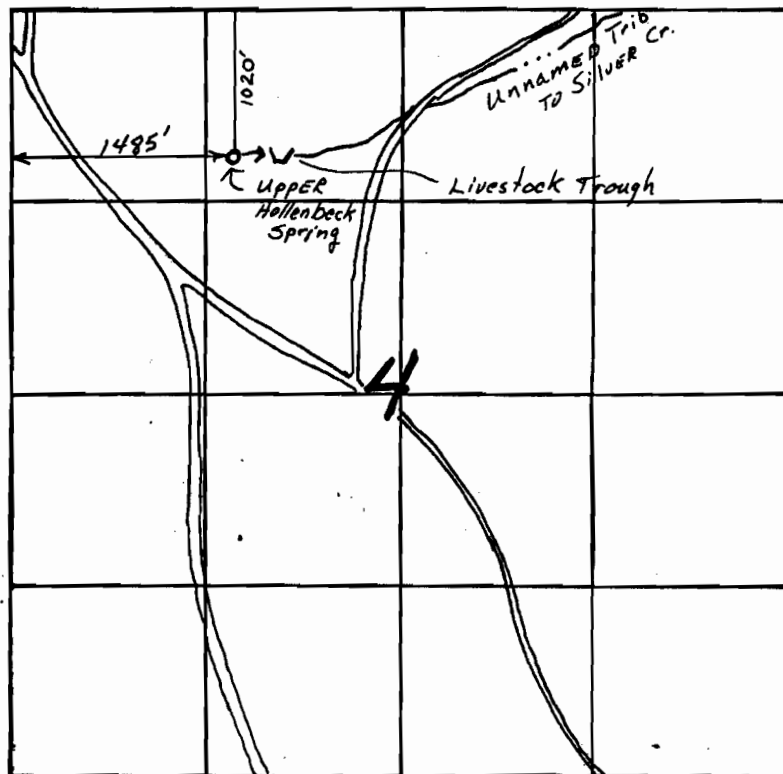

SCALE - 4" = 1 MILE

Application No. 60875
Permit No. 48528

RECEIVED
MAY 6 1983
WATER RESOURCES DEPT.
SALEM, OREGON