


# T. 24 S., R. 5 W., W.M.

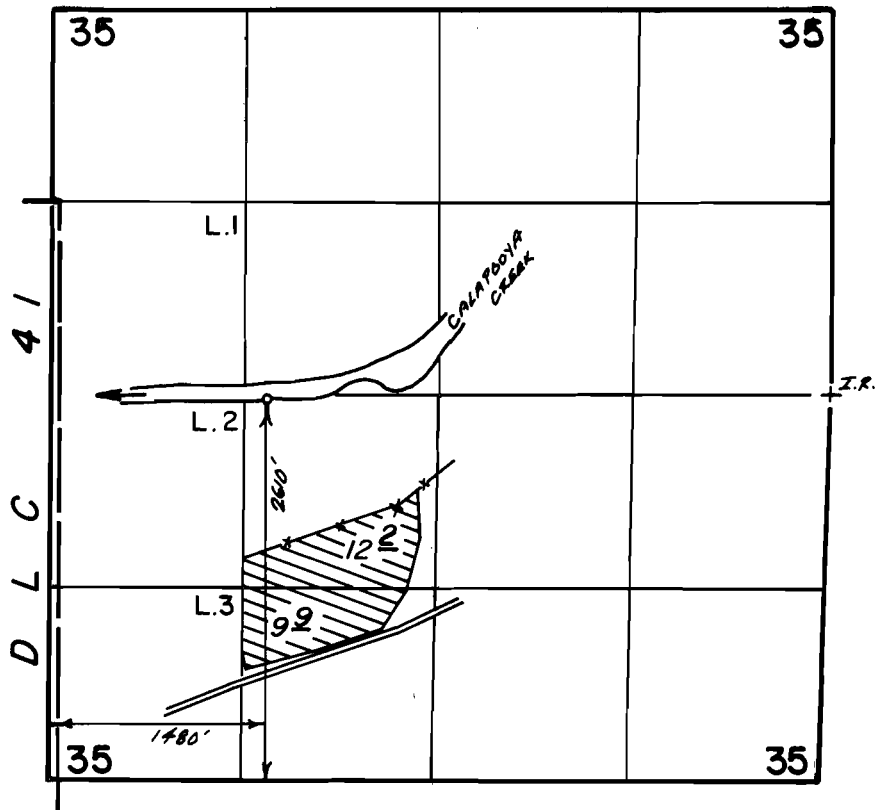

Scale 1" = 1320'



## FINAL PROOF SURVEY UNDER

Application No. 61726. Permit No. 46300...  
IN NAME OF

...CREIGHTON & PHYLLIS M. BAXTER

Surveyed Sept. 19, 1991, by B.S. James