


T. 22 S., R. 7 W., W. M.

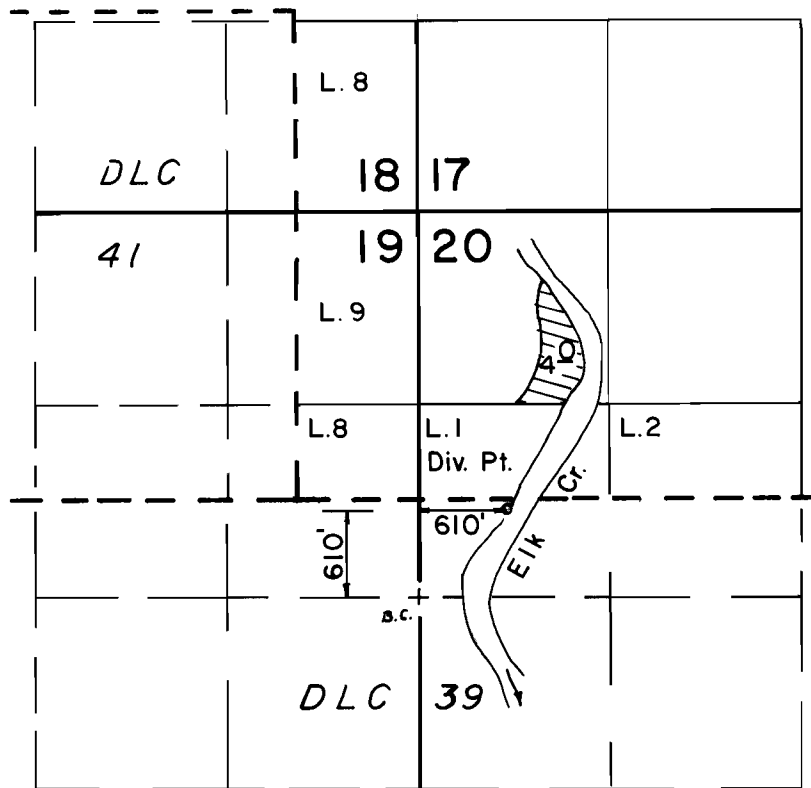

Scale: 1" = 1320'

**FINAL PROOF SURVEY
UNDER**

Application No. 61.89.7. Permit No. 46.26.7...
IN NAME OF

.....SIEGFRED J. ANDERSON.....

Surveyed SEP. 16. 1991., by B. S. JAMES...