


T. 28 S., R. 4 W., W. M.

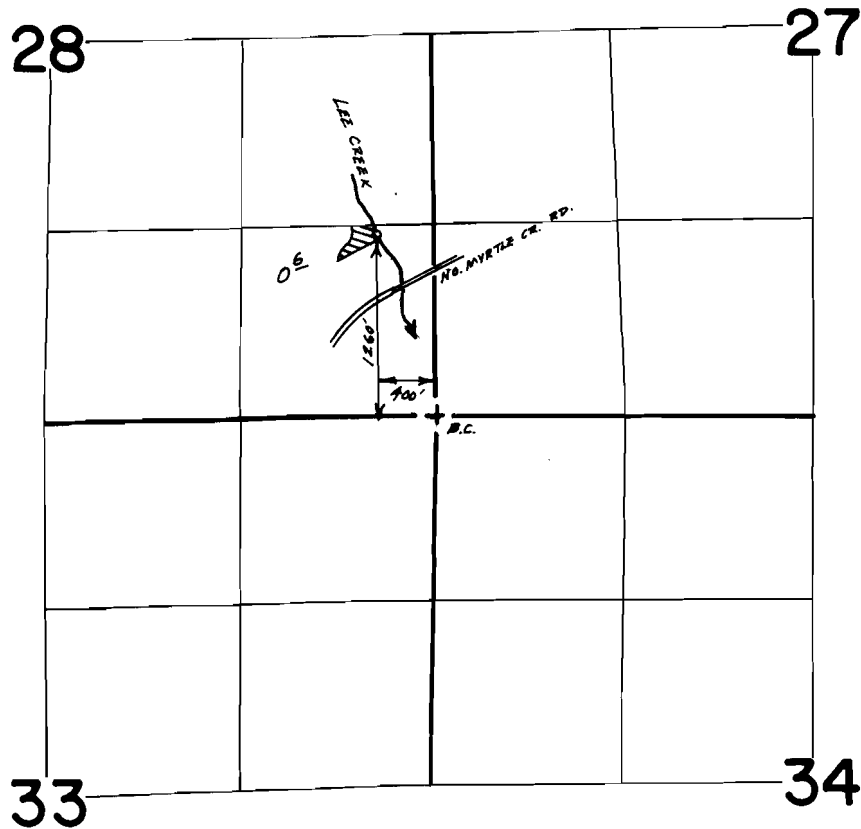

Scale 1"=1320'

**FINAL PROOF SURVEY  
UNDER**

Application No. 61959. Permit No. 46282...  
IN NAME OF

.....IRMA.....M.....PIGGOTT.....

Surveyed Nov. 27, 1989, by B.S. James.....