


T. 15., R. 38E., W. M.

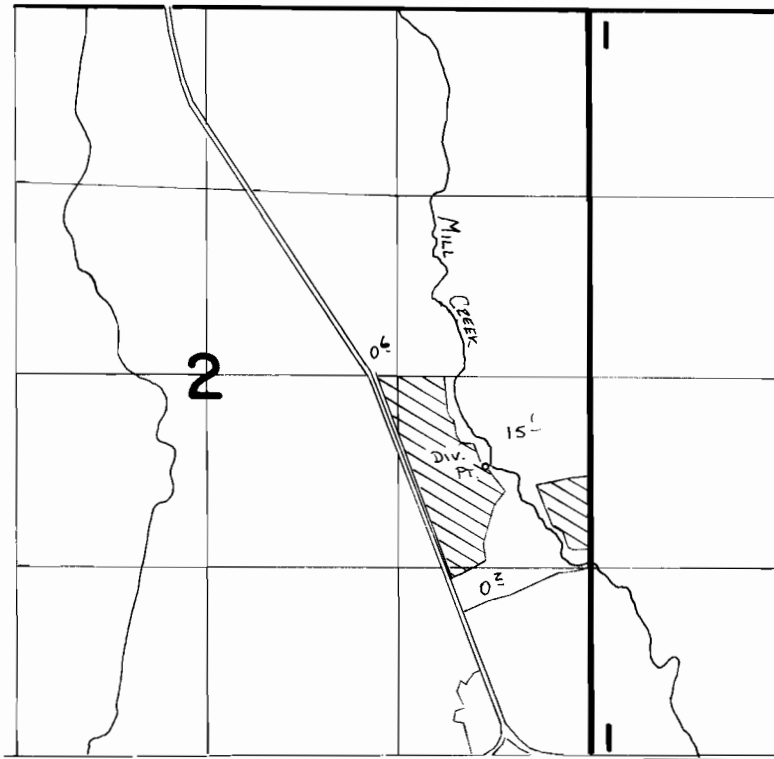

DIV. PT. LOCATED 2000' N. & 720' W. FROM SE COR. SEC. 2

FINAL PROOF SURVEY
UNDER

TRANSFER 5030

Application No. **63470** Permit No. **46990**

IN NAME OF

FREDRICK L. BEHRENS

Surveyed Aug. 23, 1983, by *V.L. Church*