


T. 40 S., R. 2 W., W. M.

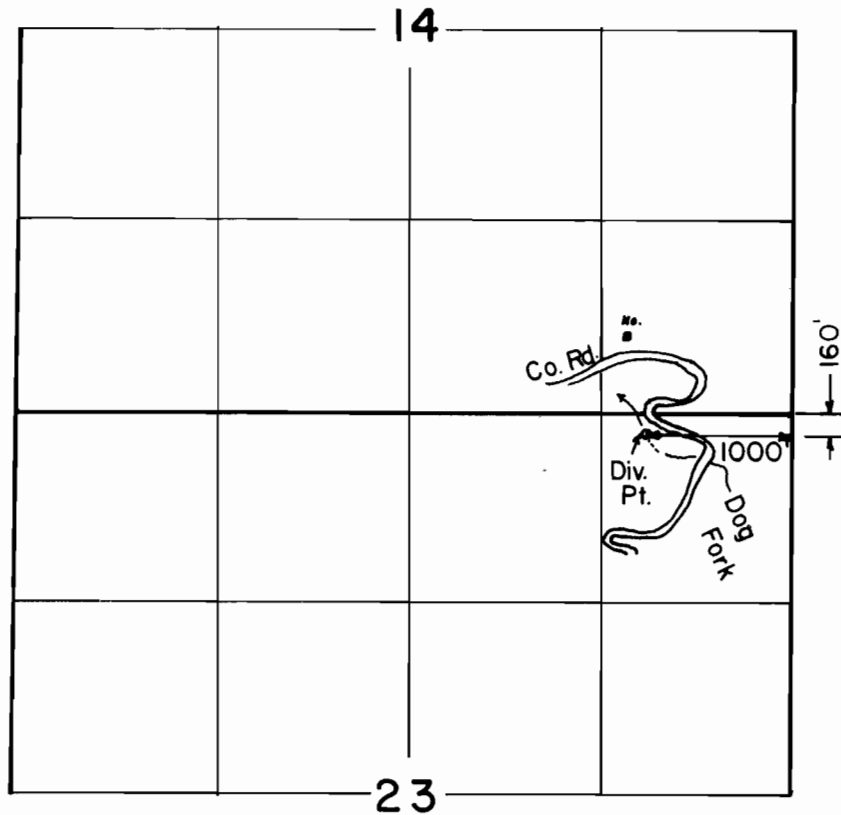

Scale: 1" = 1320'

FINAL PROOF SURVEY UNDER

Application No. 63538 Permit No. 46830...
IN NAME OF

...MARK SMAGALA.....

Surveyed Sept. 9, 1991, by B. S. Jones.....