



T. 23S., R. 5W., W.M.

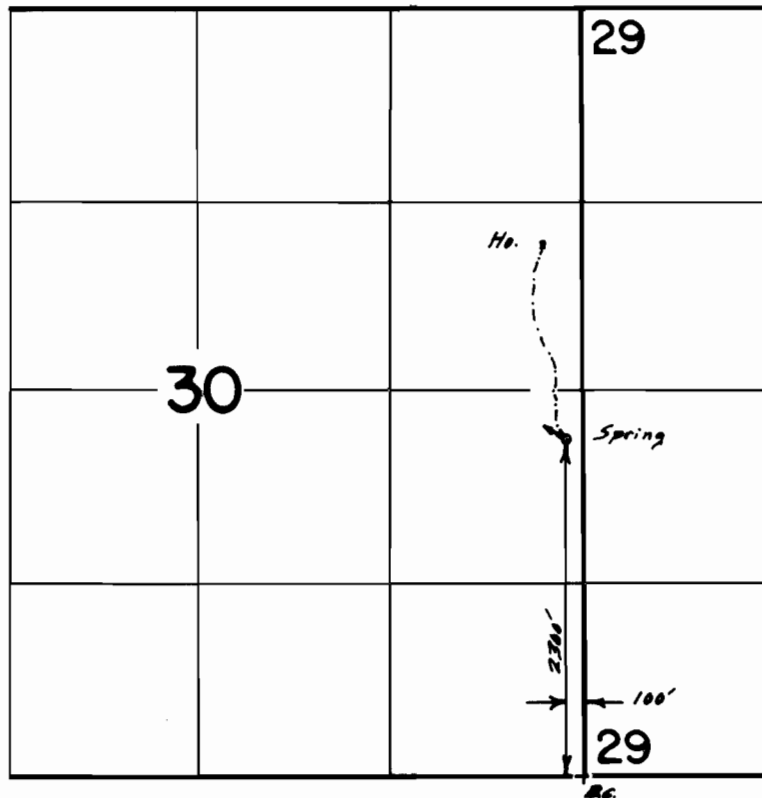

Scale 1"=1320'

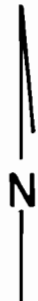

FINAL PROOF SURVEY
UNDER

Application No. 63580 Permit No. 46722...
IN NAME OF

.....MARVIN & CLARISSE CARLSON

Surveyed Sept. 12, 1991, by B.S. JAMES....