


T. 22 S., R. 7 & 8 W., W.M.

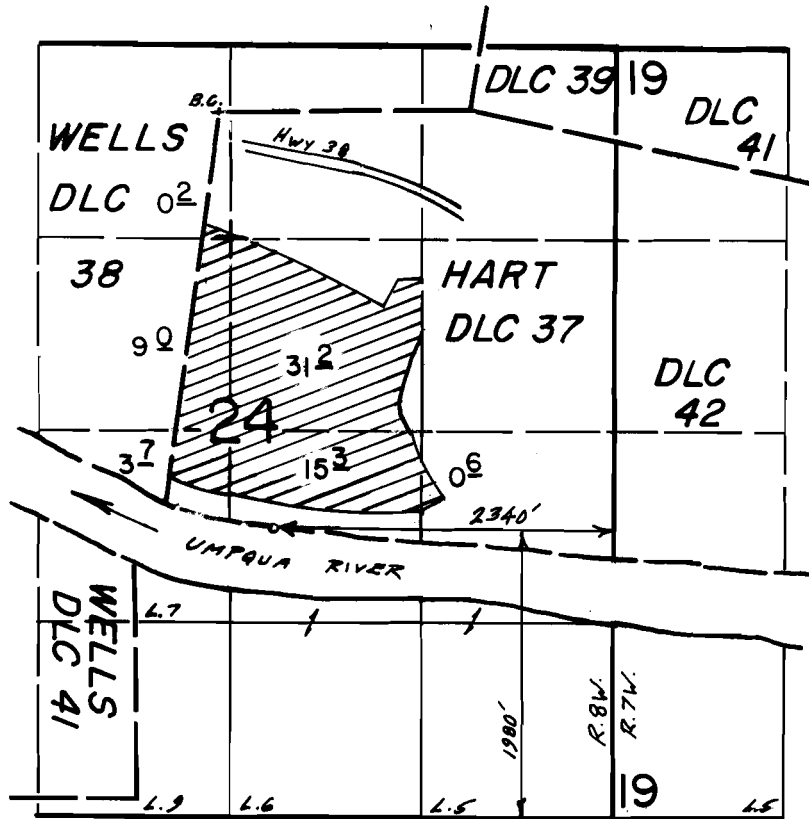

Scale 1"=1320'


FINAL PROOF SURVEY
UNDER

Application No. 63607. Permit No. 46860...
IN NAME OF

.....STEPHEN C. TROUT.....

Surveyed Aug. 8. 1991., by BS. JAMES.....

T. 22 S., R. 7 & 8 W., W.M.

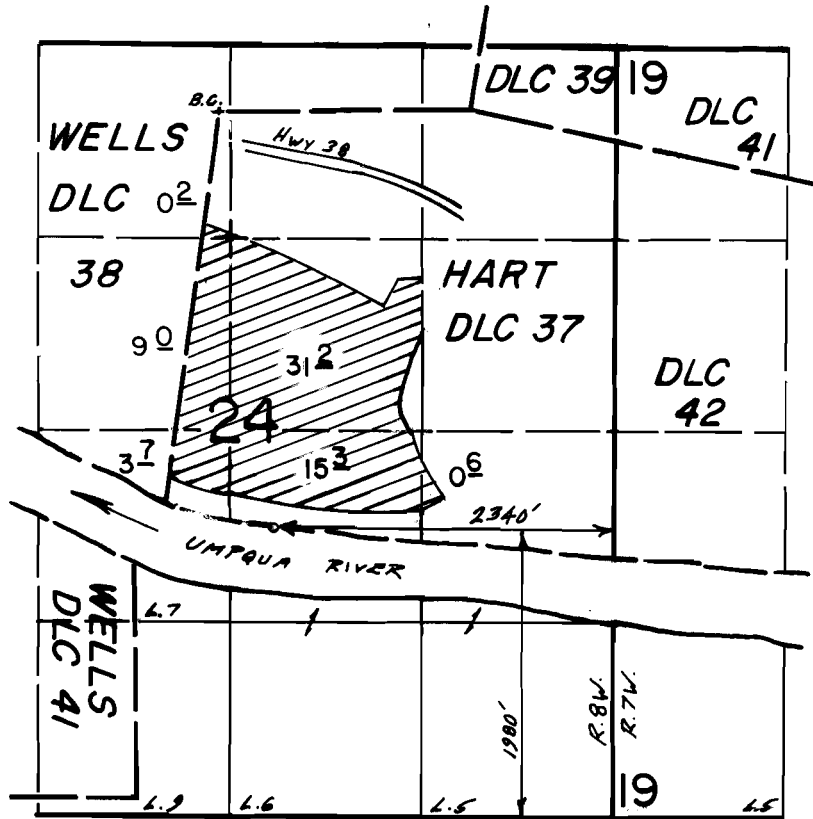

Scale 1"=1320'

FINAL PROOF SURVEY
UNDER

Application No. 63607. Permit No. 46860...
IN NAME OF

.....STEPHEN C. TROUT.....

Surveyed Aug. 8. 1991., by BS. JAMES.....