


T. 29S., R. 5 W., W.M.

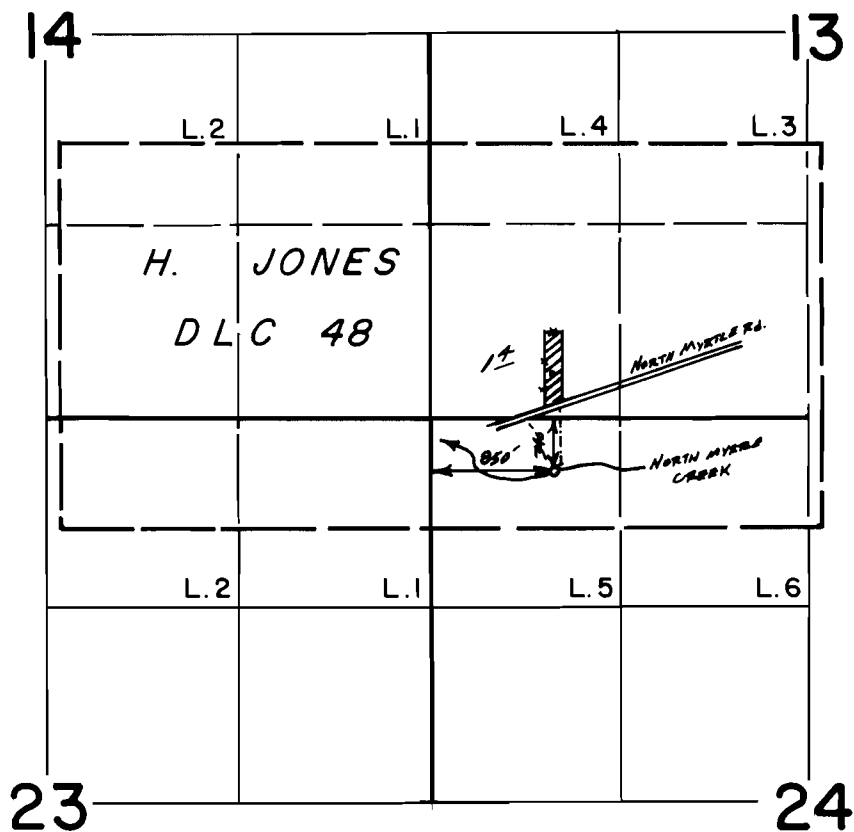

Scale 1"=1320'

**FINAL PROOF SURVEY**  
UNDER

Application No. 63695 Permit No. 46881....  
IN NAME OF

...WALTON & AUDRENE HIBDON...

Surveyed March 13, 1990, by B.S. James.....