


T. 26 S., R. 5 W., W. M.

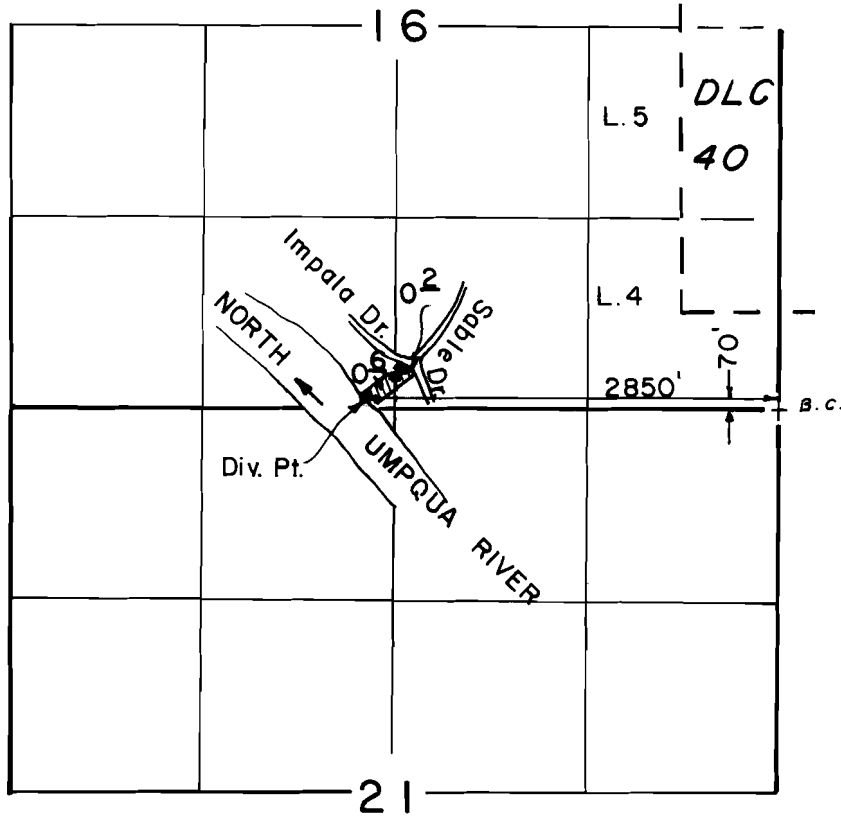

Scale: 1" = 1320'

FINAL PROOF SURVEY
UNDER

Application No. 63698 Permit No. 46996...
IN NAME OF

.....MICHELLE L. JOHNSON.....

Surveyed AUG..9.. 1990, by R..S..JAMES...