




# T. 35 & 36 S., R. 1 E., W.M.

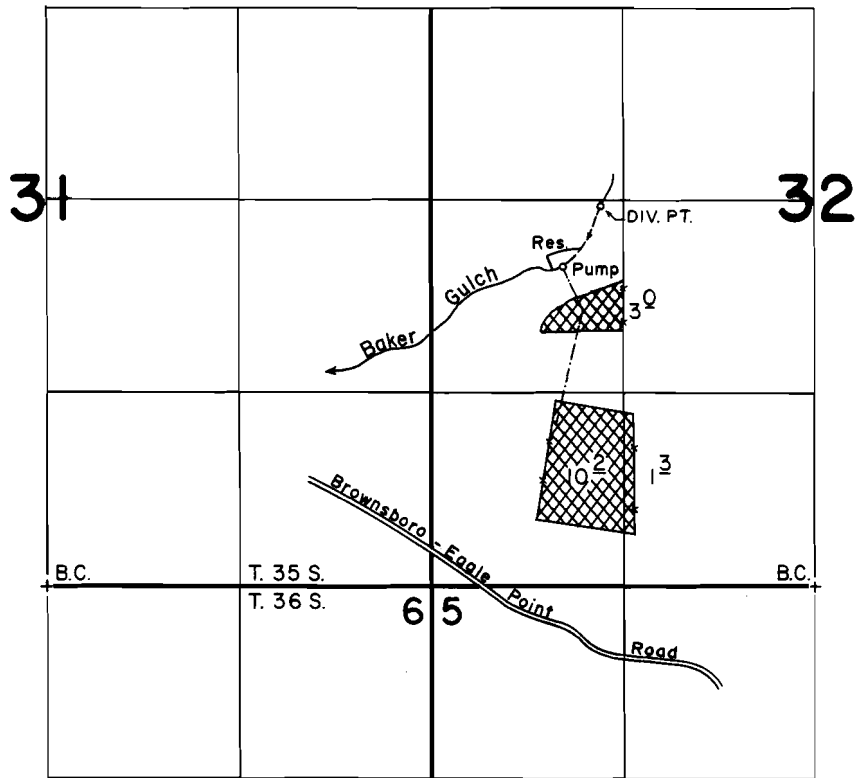

DIV. PT. LOC.: 97' S. & 1160' E. FROM THE W. 1/4 CORNER SECTION 32  
 DAM LOC.: 440' S. & 830' E. FROM THE W. 1/4 CORNER SECTION 32

SCALE: 1" = 1320'

## FINAL PROOF SURVEY

UNDER

TRANSFER NO. 5029

R-63768

R-8481

Application No. 63769 Permit No. 46934

IN NAME OF

**DONALD BIEBERSTEDT**

Surveyed AUG. 23. 1989, by B. S. JAMES



Primary



Supplemental

12-18-89

41029-279-197 L

*JS*