


T. 27 S., R. 7 W., W. M.

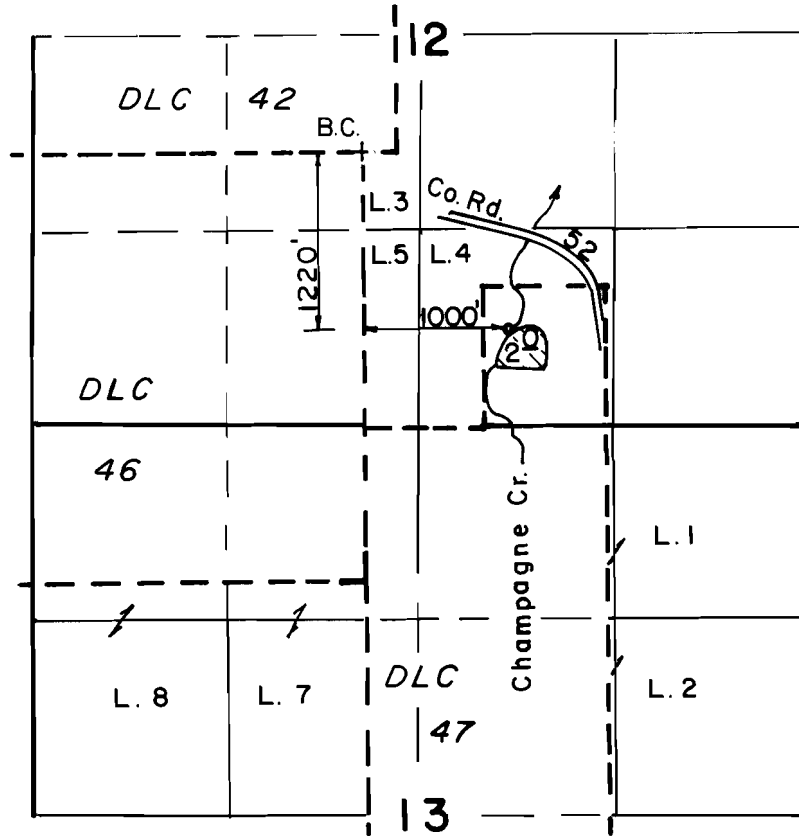

Scale: 1" = 1320'

FINAL PROOF SURVEY
UNDER

Application No. 63780 Permit No. 46936...
IN NAME OF

.....RICHARD KELLY.....

Surveyed AUG. 28 1990, by B. S. JAMES.....