


T. 34 S., R. 4 W., W. M.

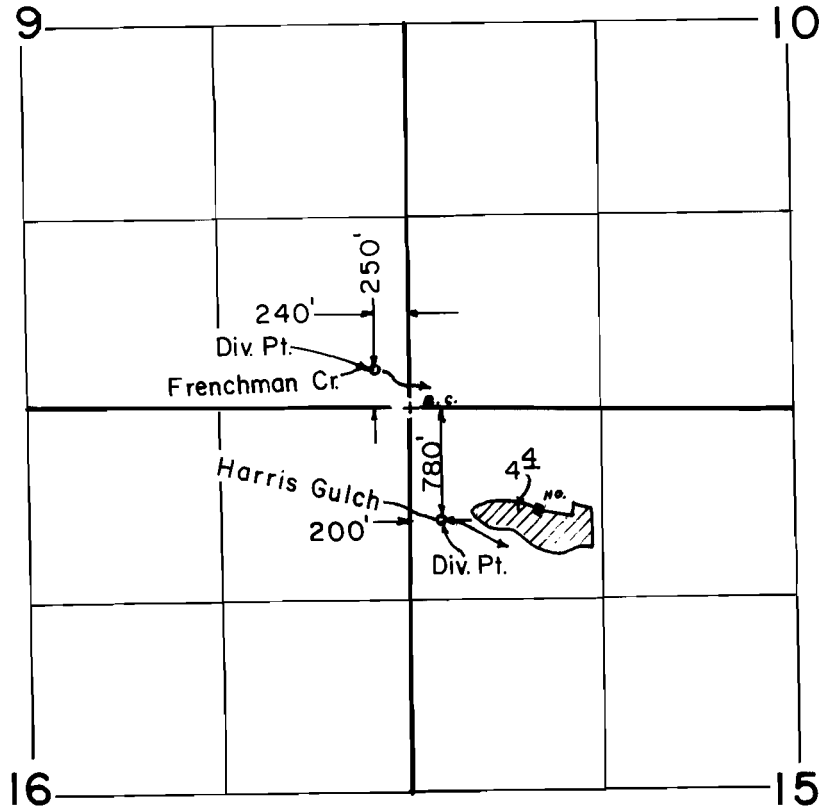

Scale: 1" = 1320'

**FINAL PROOF SURVEY
UNDER**

Application No. 64135. Permit No. 47106....
IN NAME OF

.....JOHN & GAIL GARRIDO.....

Surveyed AUG. 20 1991., by B. S. JAMES.....