


T. 26 S., R. 7 W., W.M.

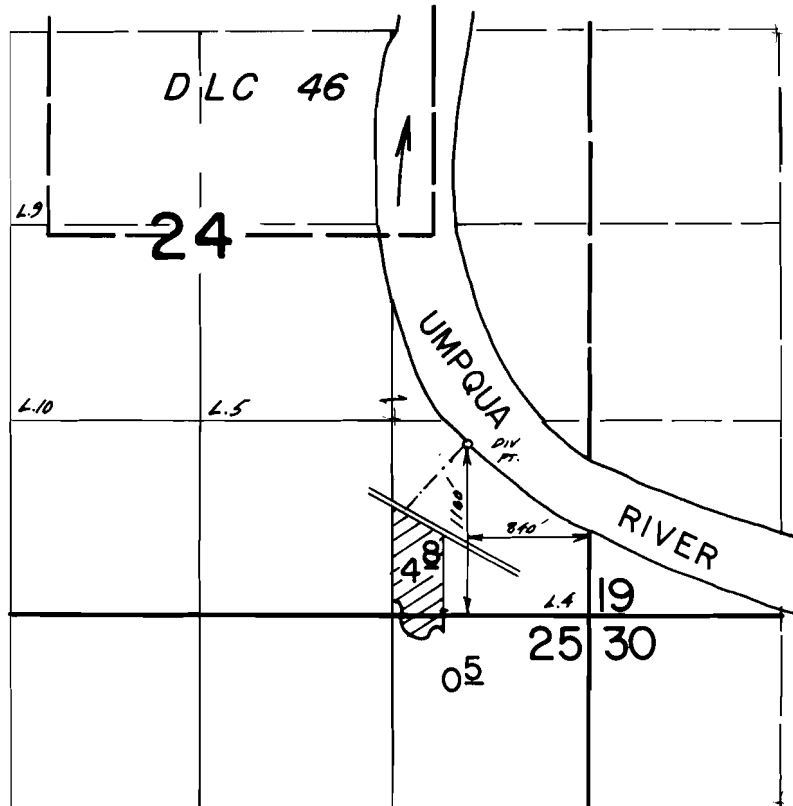

Scale 1" = 1320'

FINAL PROOF SURVEY
UNDER

Application No. 65591... Permit No. 48002...
IN NAME OF

.....*DAVID B. KERSHNER*.....

Surveyed Aug. 23, 1990., by B.S. James.....