


T. 28 S., R. 5 W., W. M.

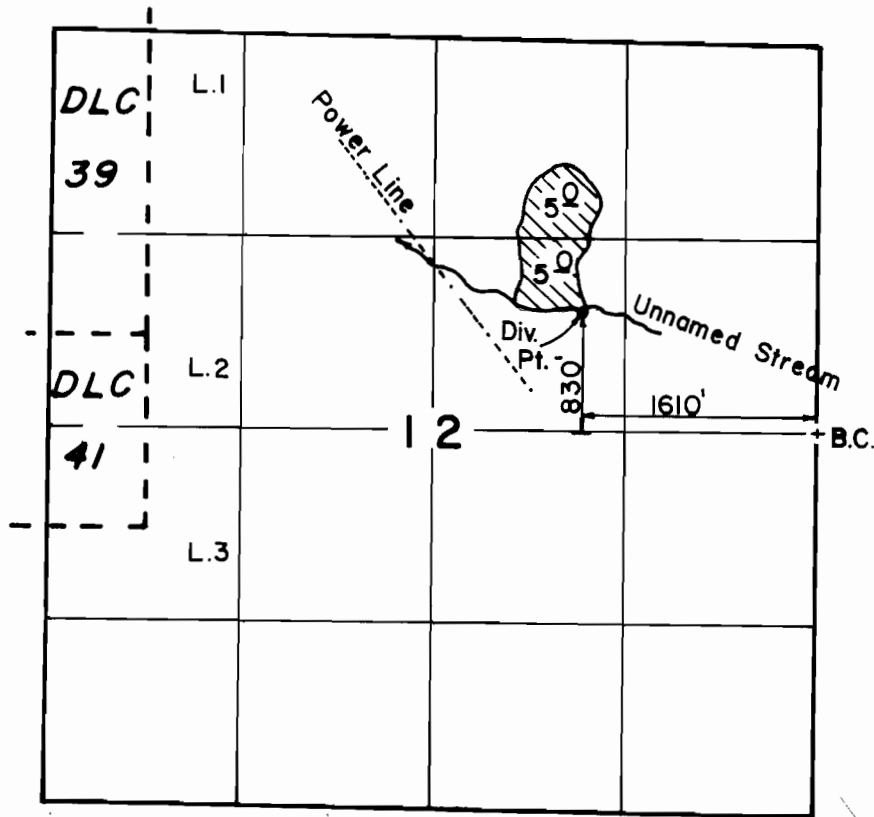

Scale: 1" = 1320'

**FINAL PROOF SURVEY
UNDER**

Application No. 6.672.5 Permit No. 4812.3...
IN NAME OF

.....BENJAMIN B. MELTON.....

Surveyed AUG. 21. 1990, by B.S. JAMES.....