


T. 30 S., R. 2 W., W. M.

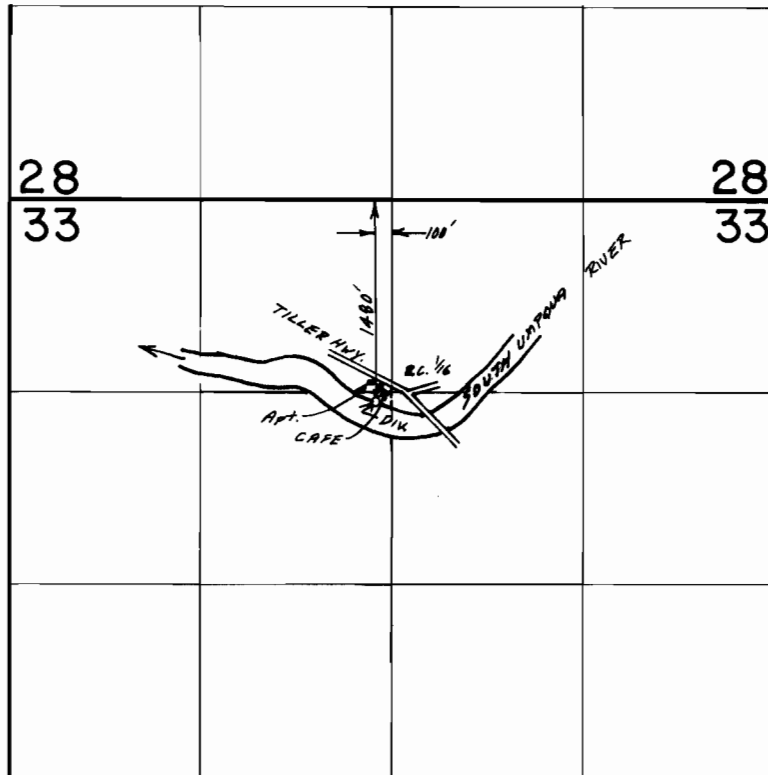

Scale 1"=1320'

FINAL PROOF SURVEY
UNDER

Application No. 67.989 Permit No. 48.412...
IN NAME OF

.....RICHARD H. CASWELL.....

Surveyed Nov. 13, 1990, by B.S. James.....