


6799 6157

Accompanying application of the COUNTY of JACKSON
State of Oregon, for permit to the waters of Tub Springs
tributary to Keene Creek, tributary to Klamath River
Jackson County, Oregon, for Irrigation, and Public
use for camping purposes.

August. 1920.

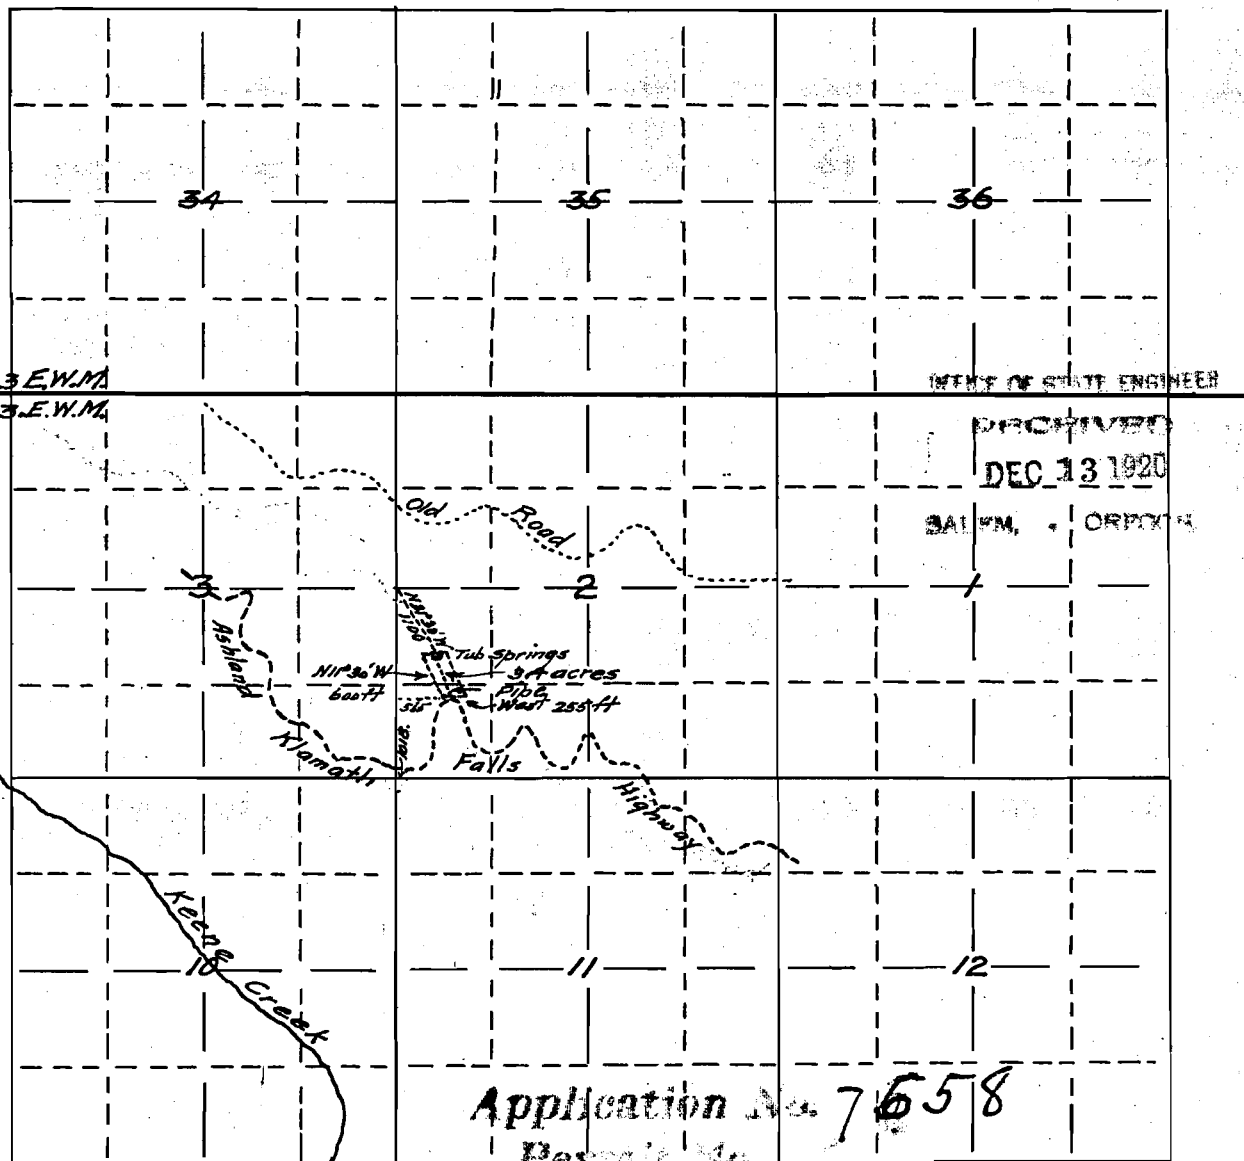

Map made from plat of Survey furnished by State Highway Division Engineer Hodgeman's Office, correctly showing location of Springs, lands to be irrigated, together with streams and ditches in immediate vicinity.
Compiled by. Fred. N. Cummins. C.

Fred. N. Cummings. C.E.
Water Master District No 15.