


T. 29 S., R. 14 W., W.M.

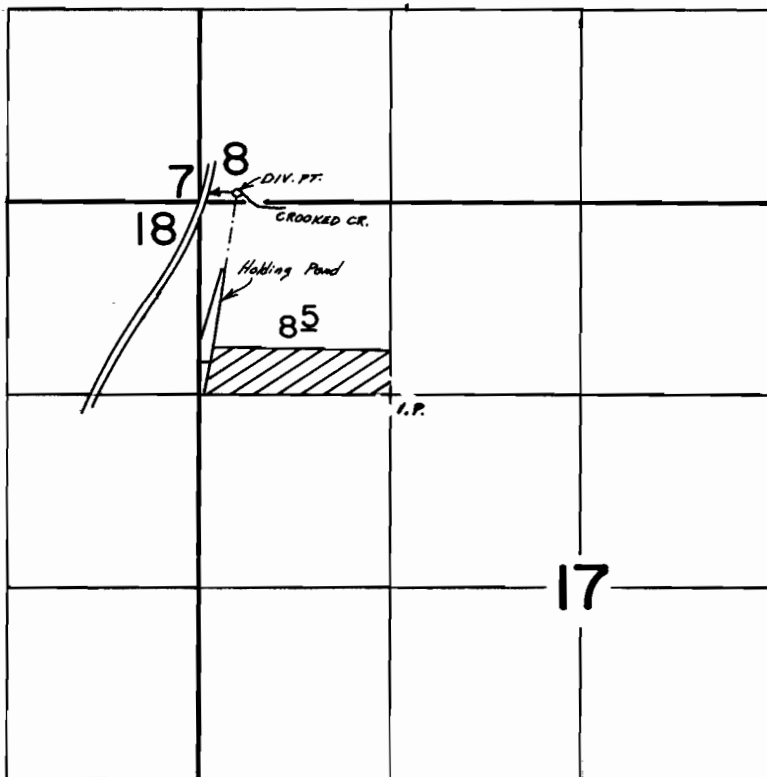

DIV. PT: 60' N $\frac{1}{2}$ 250' E FROM NW CORNER SECTION 17.

Scale 1" = 1320'

FINAL PROOF SURVEY UNDER

Application No. 68060. Permit No. 49397.....

IN NAME OF

.....HARDY.....CHRISTENSEN.....

Surveyed March 6, 1990, by B.S. James.....