


T. 27 S., R. 2 W., W M

SEC. 12

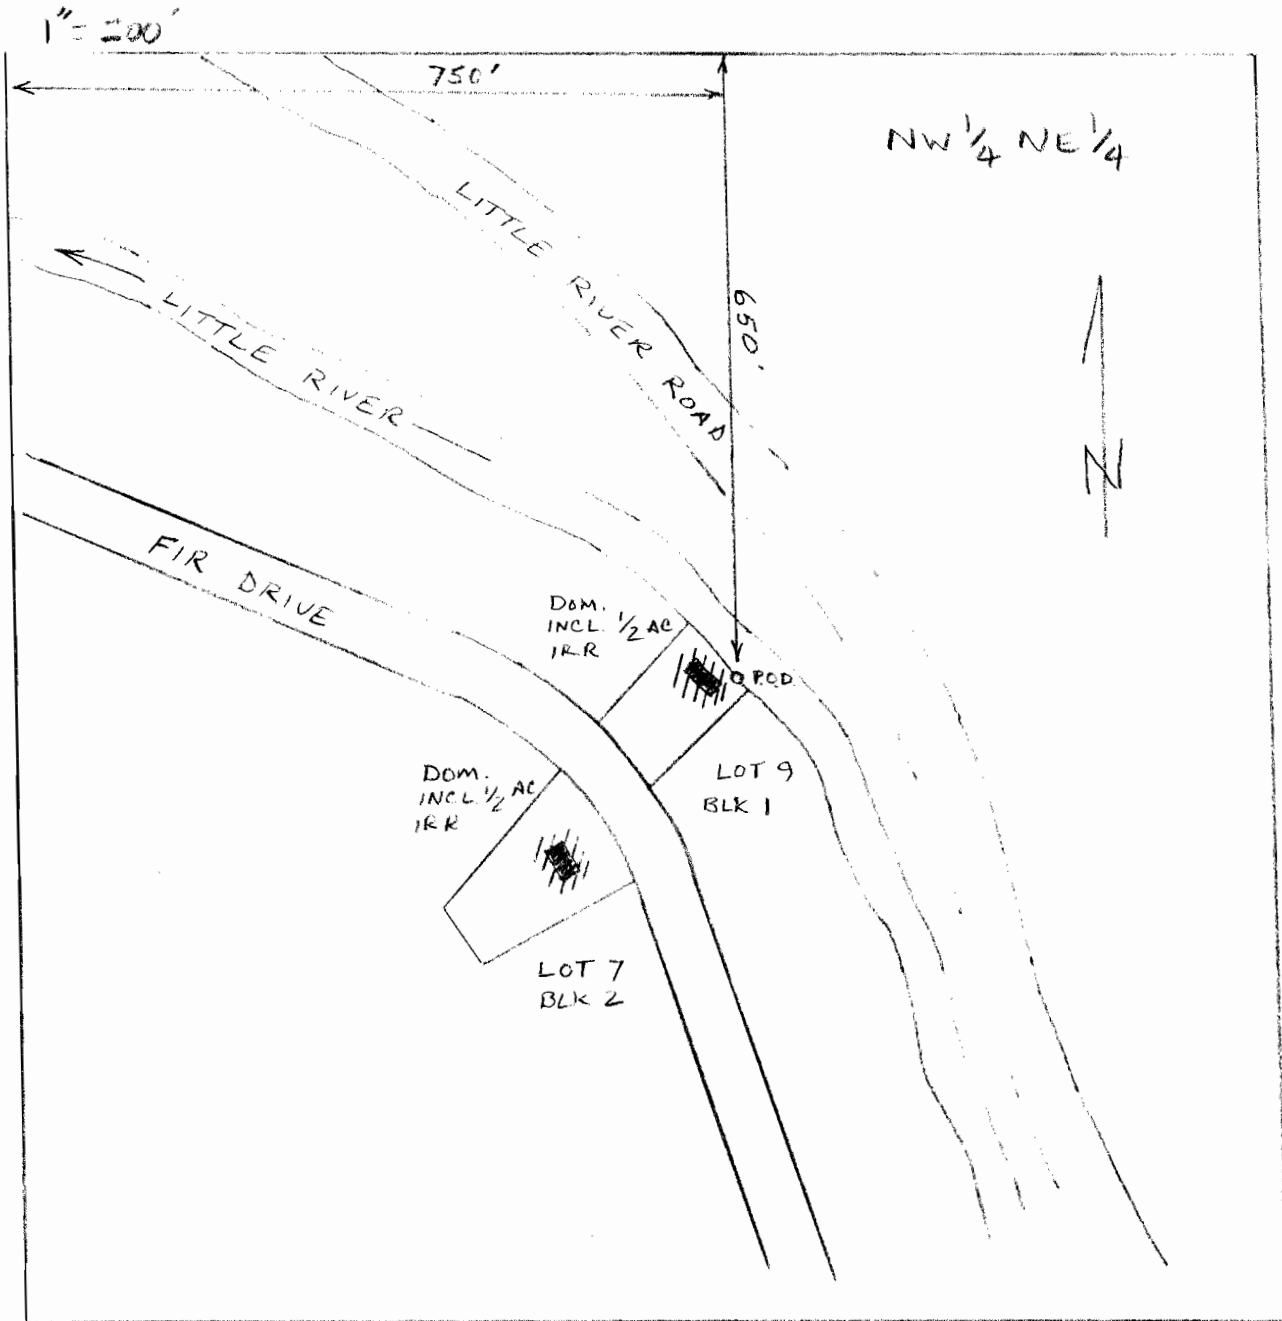

Application No. 68627
Parcel No. 49595