


T. 32 S., R. 6 W., W. M.

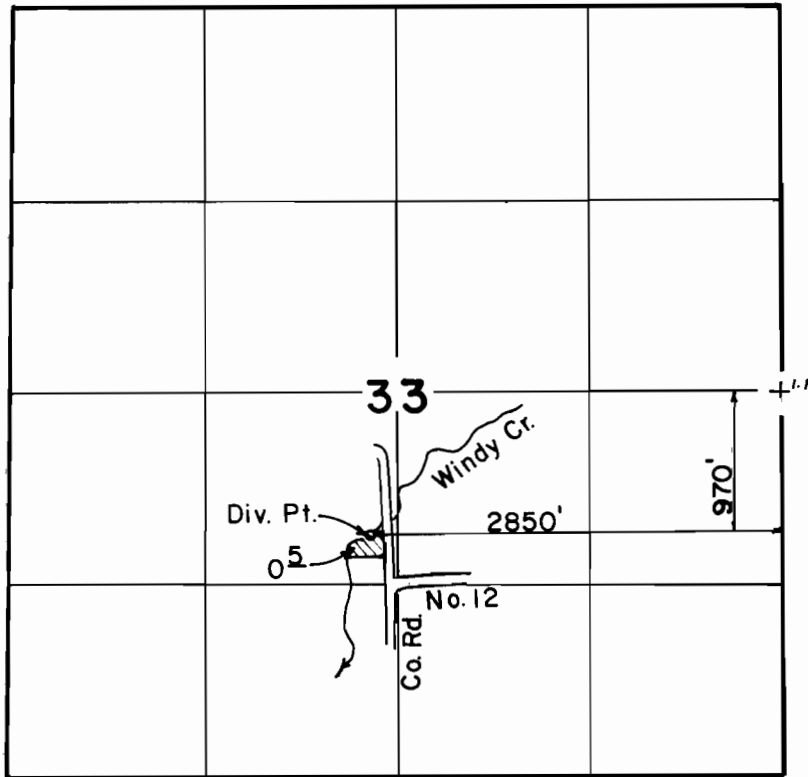

Scale: 1" = 1320'

**FINAL PROOF SURVEY
UNDER**

Application No. 68431. Permit No. 49416....
IN NAME OF

.....JOE T. & B. M. POPLIN.....

Surveyed JULY 24 1990., by B. S. JAMES....