


T. 32 & 33 S., R. 6 W., W. M.

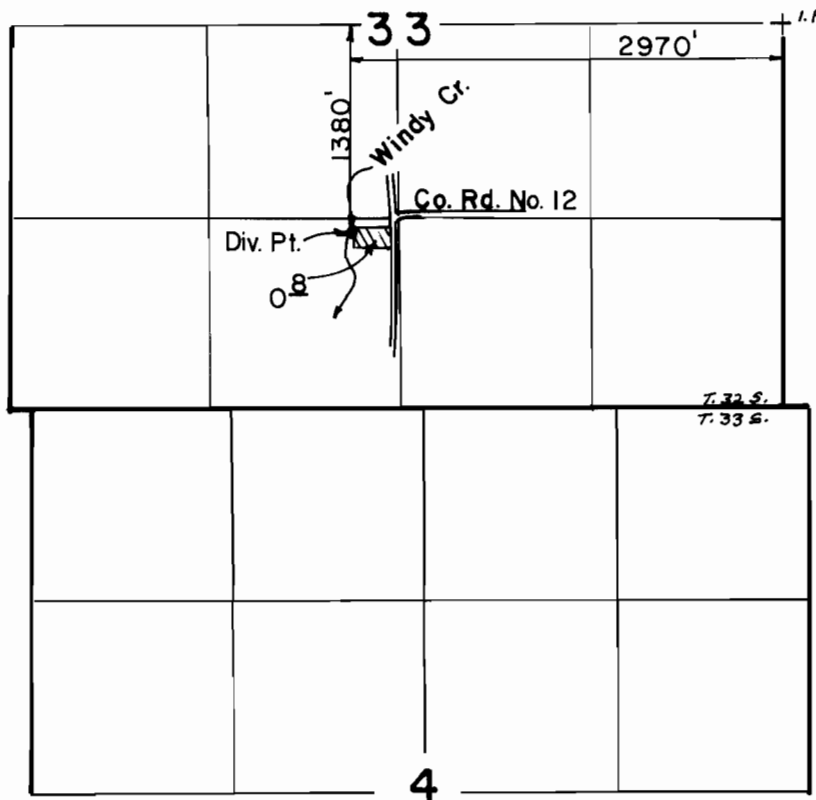

Scale: 1" = 1320'

FINAL PROOF SURVEY
UNDER

Application No. 68711.. Permit No. 49748...
IN NAME OF

SWAN & PATTY D. WILLIAMSON

Surveyed JULY 24 1990., by B. S. JAMES...