


T. 26 S., R. 5 W., W. M.

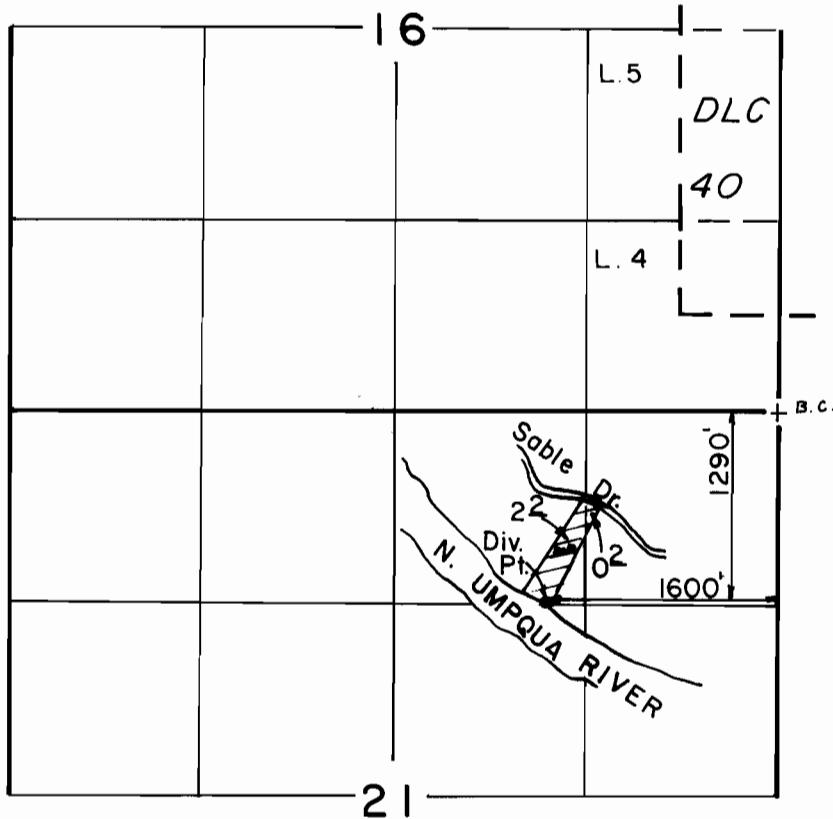

Scale: 1" = 1320'

**FINAL PROOF SURVEY
UNDER**

Application No. 68823. Permit No. 49864...
IN NAME OF

.....MICHAEL J. STANSBURY.....

Surveyed AUG...9. 1990, by R.S. JAMES....