


T. 27 S., R. 3 W., W. M.

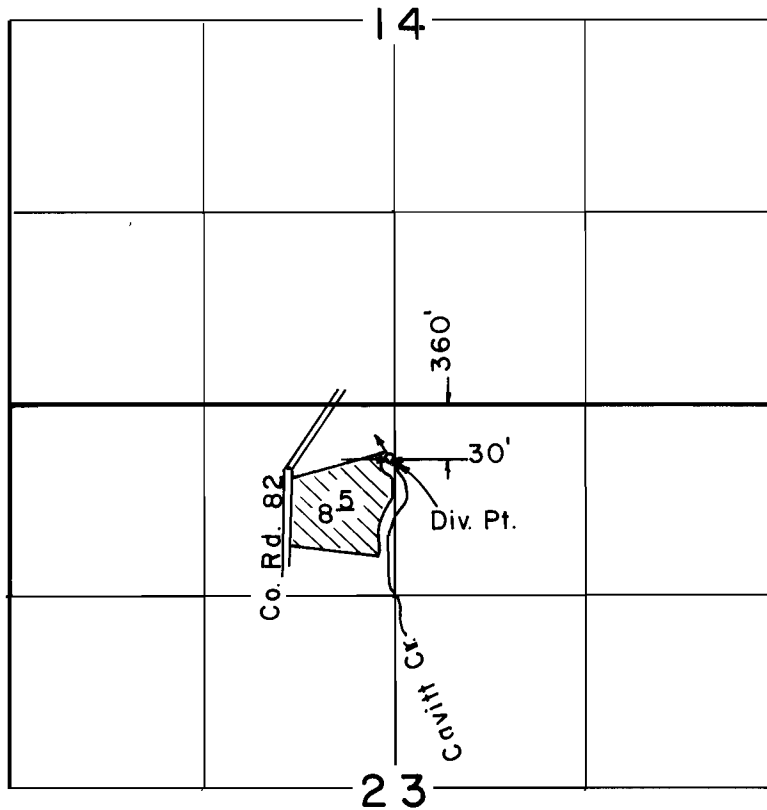

Scale: 1" = 1320'

**FINAL PROOF SURVEY  
UNDER**

Application No. 69149. Permit No. 5Q158...  
IN NAME OF

MICHAEL C. & JUDITH A. TIGHE

Surveyed AUG. 27. 1991., by B. S. JAMES....