


T. 27 S., R. 6 W., W. M.

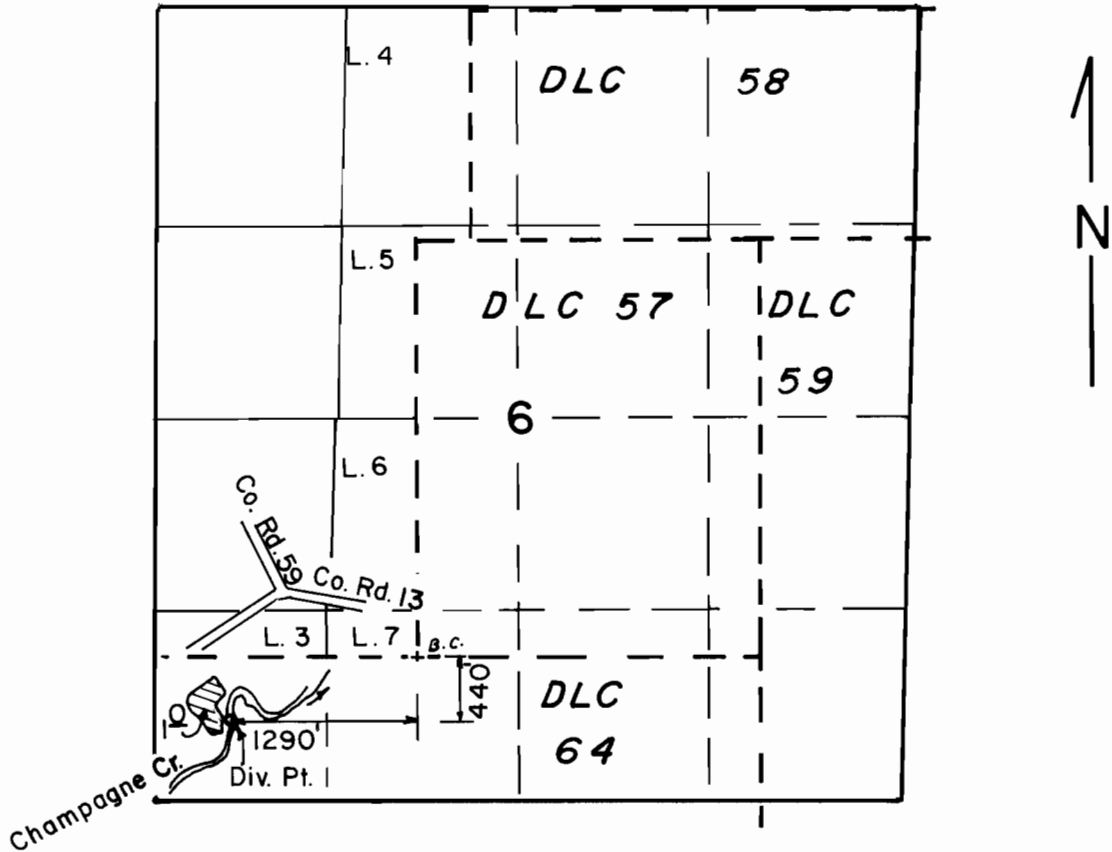

Scale: 1" = 1320'

**FINAL PROOF SURVEY  
UNDER**

Application No. 69182. Permit No. 50098...  
**IN NAME OF**

.....ARTHUR J. CROCKER.....

Surveyed AUG. 29. 19.90, by B.S. JAMES.....