



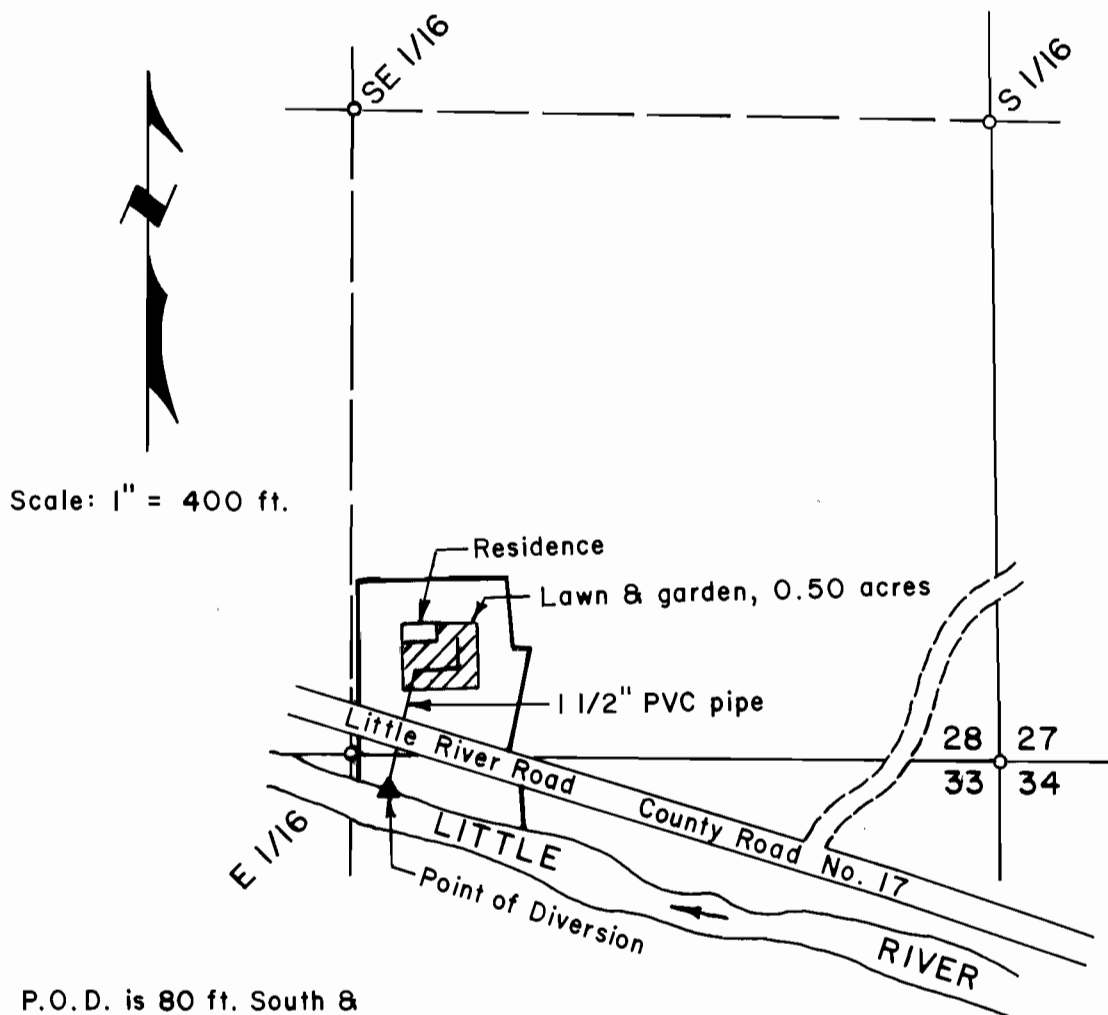

P.O.D. is 80 ft. South & 1,270 ft. West of the northeast corner of Section 33.

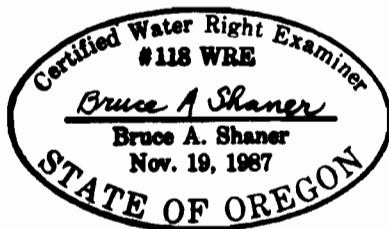

FINAL PROOF SURVEY
of the Permit to appropriate Surface Water
in the SE 1/4 SE 1/4 of Section 28 and the
NE 1/4 NE 1/4 of Section 33, T 26 S,
R 3 W, W. M., Douglas County, Oregon
Application No. 69417
Permit No. 50439

For: Frances M. Casebeer
4192 Little River Road
Glide, Oregon 97443

By: Shaner Engineering, Inc.
P. O. Box 1430
Roseburg, Oregon 97470

August 30, 1991