

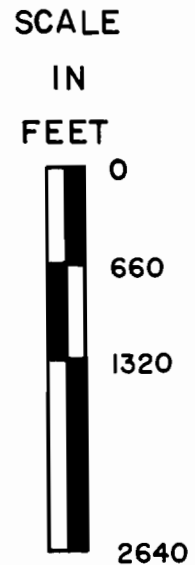


FINAL PROOF SURVEY T.39 S., R.14 W., W.M.

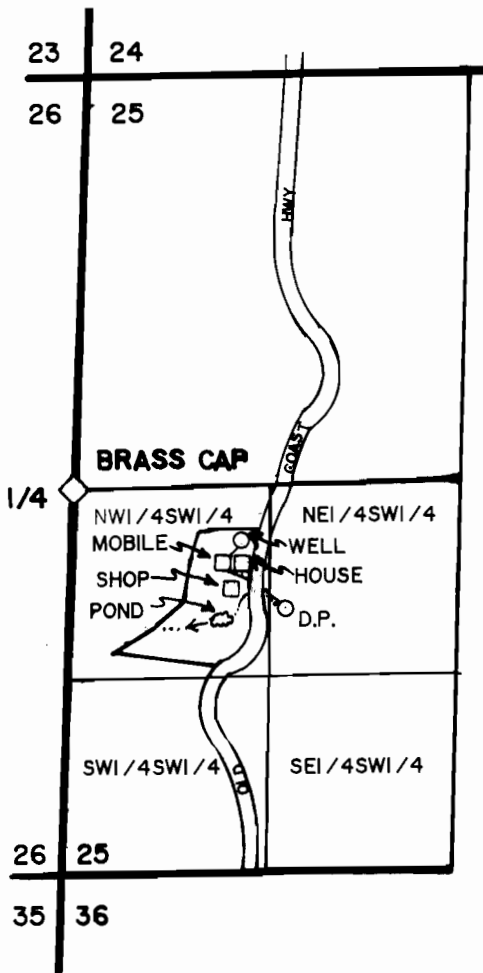

THIS MAP SHOWS THE LOCATION OF A
WATER RIGHT ONLY AND HAS NO INTENT
TO PROVIDE DIMENSIONS OR LOCATION
OF PROPERTY OWNERSHIP LINES.

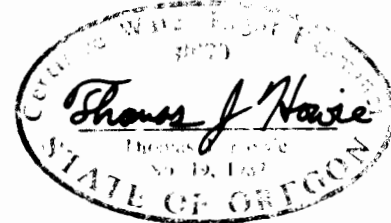

DIVERSION POINT (D.P.), LIES 806.5' SOUTH & 1443.1' EAST OF THE 1/4 CORNER OF SEC. 25 & 26.

APPLICATION NO. 70139 PERMIT NO. 51022

IN THE NAME OF DONN COMTE & NANCY COMTE

SURVEYED BY THOMAS J. HOWIE, WRE 070, IN NOV. 1989.